IREDELL COUNTY HEALTH DEPARTMENT

STATESVILLE 704-878-5305 MOORESVILLE 704-664-5281

IMPROVEMENT PERMIT / CERTIFICATE OF COMPLETION / OPERATION PERMIT / EXISTING SYSTEM INSPECTION

PROPERTY DESCRIPTION NO. _____ DATE 3-10-97 TAX MAP NO. _____ Watershed: ☐ Yes ☐ No

OWNER OR CONTRACTOR Jerry Haithcox PHONE: Business _____ Home 585-9366

ADDRESS 115 Haithcox Ln Statesville

LOCATION 90W TL Landis Ln T/R Haithcox Mobile Home

SUBDIVISION _____ BLOCK / SECTION _____ LOT _____ LOT AREA _____ SITE CLASS. _____ DESIGN FLOW 240 L.T.A.R. 0.8

Septic Tank: 1000 Gallons; STB _____ Date _____

Pump Tank: _____ Gallons; PT _____ Date _____

Pump Make: _____ Model _____ Serial No. _____

Nitrification Field: No Fields 1 Square Feet _____ Linear Feet 200FT

No Lines 2 Trench Width 36in Max Trench Bottom Depth 36in Gravel Depth 12in

☐ New System ☒ Repair System Type: I (II) III, IV, V, VI

System Description: _____

Repair System Description: Gravity Conventional

Maintenance Agreement Required: ☐ Yes ☐ No

☐ House/Mod. Home ☒ Mobile Home ☐ Business ☐ Other

No. Bedrooms 2 No. Bathrooms 2 No. Employees _____


☐ Slab ☒ Crawl Space ☐ Basement w/plumbing ☐ Basement wo/plumbing

Water Supply: ☐ Individual ☐ Community ☒ Public


Comments: Keep lines on contour 9ft on center Check sanitary T. Replace if needed.

Comments:

INITIAL SITE SKETCH

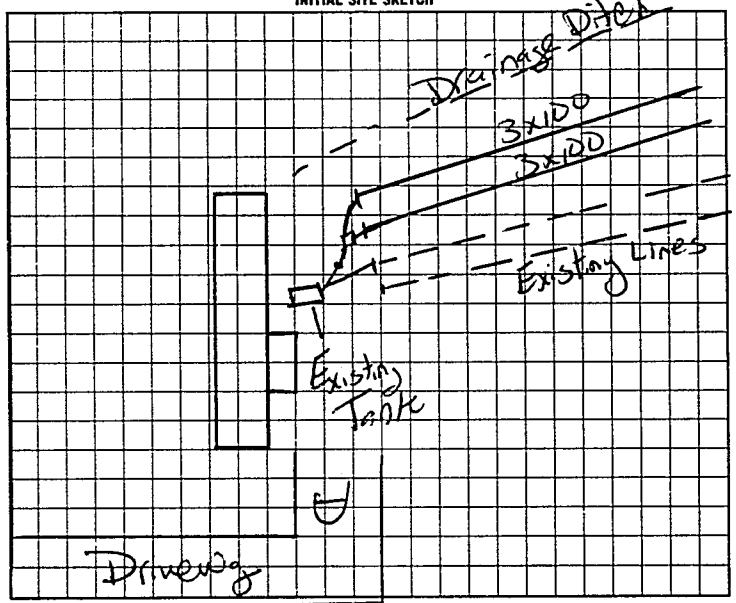

AS BUILT SKETCH

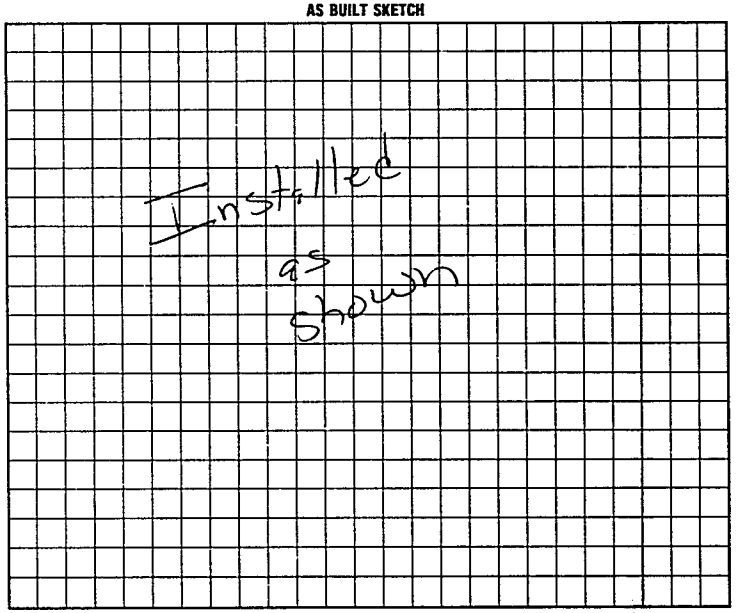

I understand that this permit can be suspended or revoked if any false information is supplied toward securing the permit/any unauthorized changes are made to the site/any unauthorized changes are made in the installation of the system. Improvement Permit is valid for 60 months from date of issuance. Authorization to construct expires 5yrs from issue date

Signed: Jerry A Haithcox

Improvement Permit by: Mary C Oates date 3-10-97

Existing System Inspection by: Authorization to Const. Mary C Oates date 5-10-97

Installed by: James Huddler

Certificate of Completion by: _____ date _____

Operation Permit by: Mary C Oates date 4-16-97

HEALTH DEPT. COPY: WHITE INSPECTION COPY (FINAL): GREEN OWNER COPY (FINAL): YELLOW INSPECTION COPY (INITIAL): PINK OWNER COPY (INITIAL): GOLD

L28000