IREDELL COUNTY HEALTH DEPARTMENT

Statesville Phone TR 3-7271 Mooresville Phone NO 3-1271

PERMIT TO INSTALL SEPTIC TANK

Permit No. _____ Permit Date _____ 19__

Owner Bobby Jones Address Taylorsville R.F.D. 3

Installed By Wayne Mays Address Taylorsville N.C.

Location of Property Hwy 90 Past Scotts High Sch


see, on left past paved Rd.

Tank		Capacity		Length of Lines		Fixtures	
Block	( )	1000	( )	225'	( )	No. of Baths	( )
Precast	( )	1250	( )	250'	( )	Dishwasher	( )
		1500	( )	Other _____		Garbage Grdr.	( )
		Other _____				Other _____	

NOTIFY HEALTH DEPARTMENT AT LEAST EIGHT HOURS BEFORE TANK IS TO BE INSPECTED.

Final Inspection 11-8 1965 Approved ( ) Disapproved ( )

Remarks City Water.

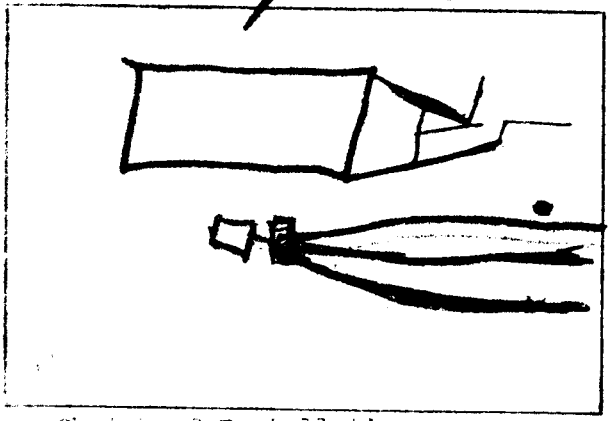

Sketch of Installation

Andrew J. Hutchins R.S.

Sanitarian