IREDELL COUNTY HEALTH DEPARTMENT

THIS PERMIT VOIDS PREVIOUS ISSUED 2-4-98

STATESVILLE 704-878-5305 MOORESVILLE 704-664-5281

IMPROVEMENT PERMIT / AUTHORIZATION TO CONSTRUCT / OPERATION PERMIT / EXISTING SYSTEM INSPECTION

PERMIT# 97667 PIN# 4707 02 5949 DATE 2-26-98

OWNER OR CONTRACTOR JAMES & BARBARA HAYES PHONE: Business 878-4661 Home 546-2611

ADDRESS 516 FAIRMOUNT ROAD STATESVILLE, N.C. 28625

LOCATION NC 90 W, LAST DRIVE ON RIGHT BEFORE MIAWAY ROAD, ~ 400' OFF ROAD

SUBDIVISION _____ BLOCK / SECTION _____ LOT _____ LOT AREA 1.000 ACRE SITE CLASS. PS DESIGN FLOW 360 L.T.A.R. 0.30 GAD/FT²

Septic Tank: 1000 Gallons; STB 1012 Date 8-4-98

Pump Tank: _____ Gallons; PT _____ Date _____

Pump Make: _____ Model _____ Serial No. _____

Nitrification Field: No Fields 1 Square Feet 1200 Linear Feet 400

No Lines FOUR Trench Width 36" Max Trench Bottom Depth 36" Gravel Depth 12"

☒ New System ☐ Repair System Type: I, II, III, IV, V, VI

System Description: CONVENTIONAL GRAVITY

Repair System Description: CONV. GRAVITY

Maintenance Agreement Required: ☐ Yes ☒ No

☒ House/Mod. Home ☐ Mobile Home ☐ Business ☐ Other

No. Bedrooms 3 No. Bathrooms 2 No. Employees ____


☐ Slab ☐ Crawl Space ☒ Basement w/plumbing ☐ Basement wo/plumbing

Water Supply: ☐ Individual ☒ Public ☐ Community

Comments:/Conditions: SEE ATTACHED SEWAGE EASEMENT FOR ROBERT C. LACKEY PROPERTY

Comments:/Conditions:

INITIAL SITE SKETCH

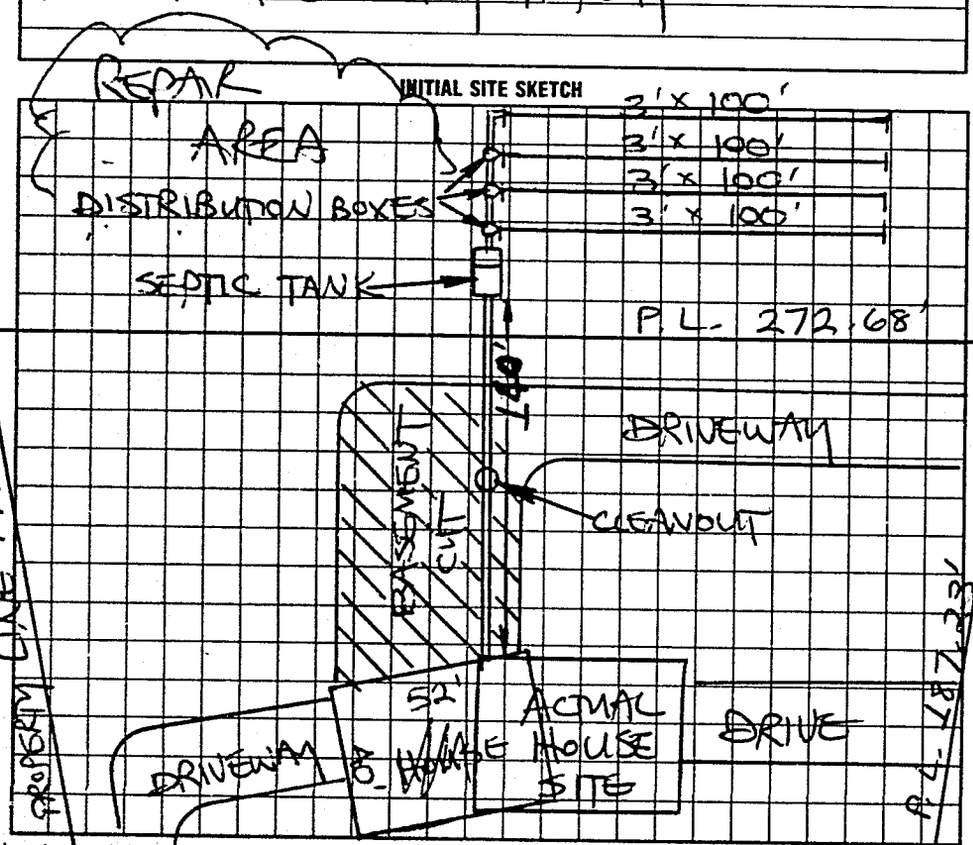

AS BUILT SKETCH

SYSTEM INSTALLED AS SHOWN ON INITAL SITE SKETCH

I understand that this permit can be suspended or revoked if any false information is supplied toward securing the permit/any unauthorized changes are made to the site/any unauthorized changes are made in the installation of the system. Improvement Permit with plat valid without expiration. Improvement Permit with site plan valid for sixty months. Authorization to Construct is valid for a period equal to that of Improvement Permit – not to exceed sixty months.

Signed: Barbara J. Hayes date 2-27-98 Installed by: STEVE JORDAN

Improvement Permit by: STEVE HEDRICK date 2-26-98 Operation Permit by: STEVE HEDRICK date 10-5-98

Authorization to Construct by: STEVE HEDRICK date 2-26-98 Existing System Inspection by: _____ date _____

HEALTH DEPT. COPY: WHITE INSPECTION COPY (FINAL): GREEN OWNER COPY (FINAL): YELLOW INSPECTION COPY (INITIAL): PINK OWNER COPY (INITIAL): GOLD

6 5 8 1 0 0