IREDELL COUNTY HEALTH DEPARTMENT

Statesville Office (704) 878-5305 Mooresville Office (704) 660-3625 PERMIT # 218532

IMPROVEMENT PERMIT / AUTHORIZATION TO CONSTRUCT / OPERATION PERMIT / EXISTING SYSTEM

PIN # 4707168859

APPLICANT: Freedom Homes APPLICANT ADDRESS: 1129 Charlotte Hwy Troutman NC

SITE ADDRESS: 152 Harris Bridge Rd - Stony Point NC PHONE: 704-528-1960 ALT. PHONE: 704-876-5866

SITE DIRECTIONS: 115N T/L Midway Rd T/R Harris Bridge Rd Lot on right

SUBDIVISION: N/A SECTION: N/A LOT # N/A LOT AREA: 0.927ac DESIGN FLOW: 240 L.T.A.R.: Ex


Septic Tank	Ex (gal)	STB	Date	☐ New System ☐ Repair ☐ Expansion	System Type: I ☒ II III IV V VI	☒ Residence	No. Bedrooms 2
Pump Tank	(gal)	PT	Date	System Description: Existing		☐ Business	No. Persons 4
Pump Make	Model		Serial #	Repair System Description:		☐ Other	No. Employees
# Nitrification Fields	Ex # Lines Ex		Linear Ft: Ex	Maintenance Agreement Required:	☐ YES ☒ NO	☐ Slab	☒ Crawl Space
Trench Width	Ex Max. Trench Bottom Depth Ex		Gravel Depth Ex	☑ GRAVITY	☐ PRESSURE	☐ Basement w/plumbing	☐ Basement w/o plumbing

Water Supply: ☒ Private ☐ Public ☐ Community


Comments / Conditions: All building foundations must be 5' from any part of STS and 725' from any well!

INITIAL SITE SKETCH

1"=40

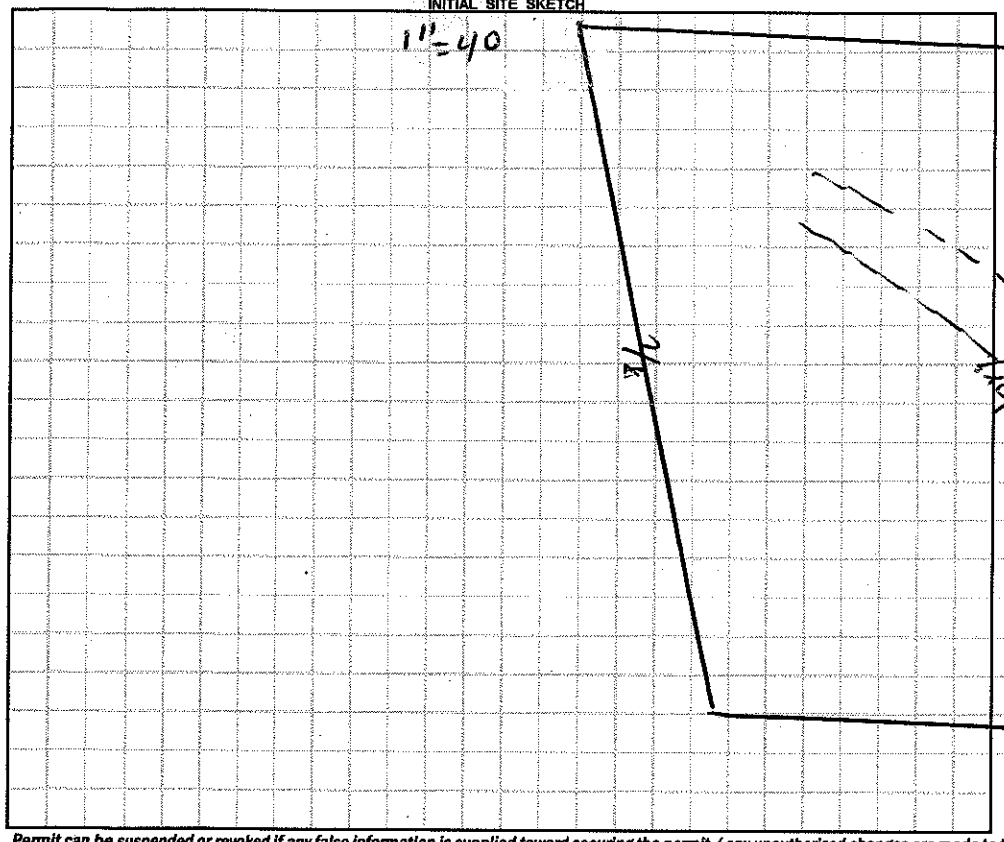

AS BUILT SKETCH

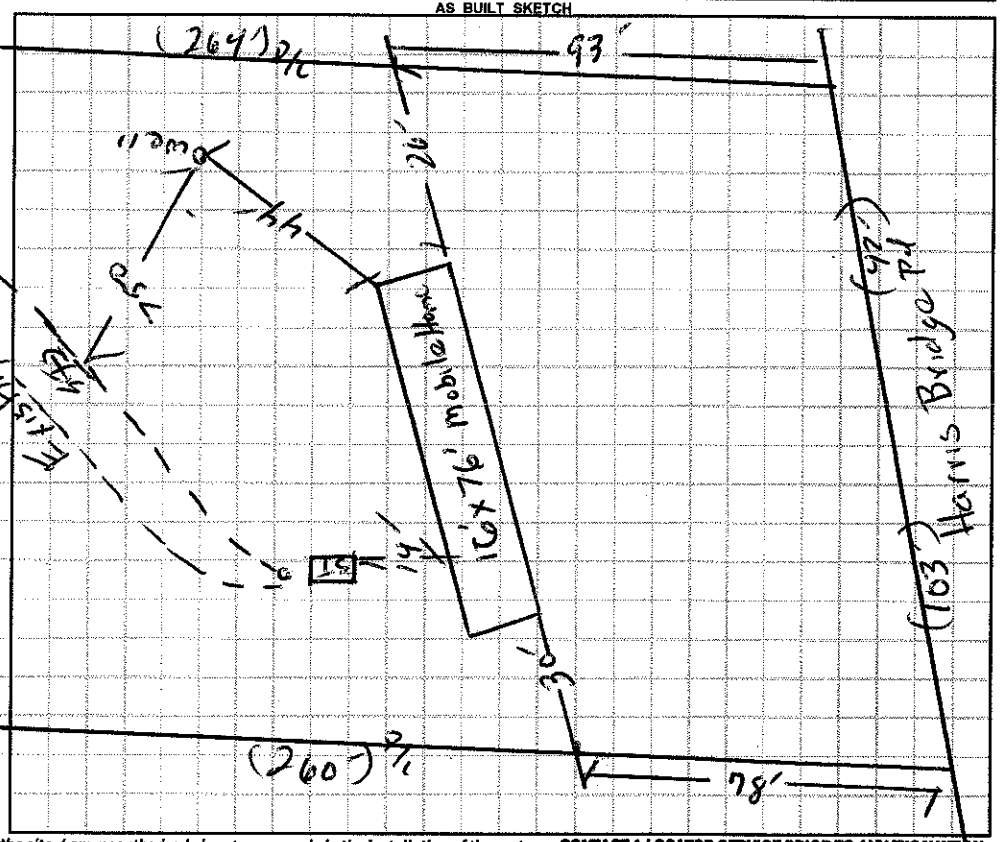

Permit can be suspended or revoked if any false information is supplied toward securing the permit / any unauthorized changes are made to the site / any unauthorized changes are made in the installation of the system. **CONTACT A LOCATOR SERVICE PRIOR TO ANY EXCAVATION**

☐ **IMPROVEMENT PERMIT** ***with plat*** *valid without expiration.* ☐ **IMPROVEMENT PERMIT** ***with site plan*** *valid for 60 mos.* ☐ **AUTHORIZATION TO CONSTRUCT** *valid for period equal to IMPROVEMENT PERMIT--not to exceed 60 mo.*

Owner / Applicant Signature: Issued w/o signature 7/19/16 Date: Installed by:

IMPROVEMENT PERMIT by: Date: OPERATION PERMIT by: Date:

AUTHORIZATION TO CONSTRUCT by: Date: Existing System Inspected by: Date: 08/29/16

Health Dept. Copy - WHITE Applicant (Final Approval) - YELLOW Applicant (Conditional Approval) - PINK