IREDELL COUNTY HEALTH DEPARTMENT

STATESVILLE 704-878-5305 LF MOORESVILLE 704-664-5281

IMPROVEMENT PERMIT / AUTHORIZATION TO CONSTRUCT / OPERATION PERMIT / EXISTING SYSTEM INSPECTION

PERMIT# 125182 PIN# 4707-34-3619 25 5002 DATE 12-15-04

OWNER OR CONTRACTOR BENNY N. JOHNSON PHONE: Business Home (704) 881-5217

ADDRESS 1540 MIDWAY RD. STONY POINT NC 28678

LOCATION HWY 115N TL MIDWAY RD 5 MILES ON LT. 2ND DRIVEWAY PAST ABNER RD

SUBDIVISION BLOCK / SECTION LOT LOT AREA 41.0 SITE CLASS. PS DESIGN FLOW 360 L.T.A.R. 0.30 gpd/ft²

Septic Tank: 1000 Gallons; STB 1007 Date 6-7-05
Pump Tank: Gallons; PT Date
Pump Make: Model Serial No.
Nitrification Field: No Fields 1 Square Feet 1200 Linear Feet 400'
No Lines 3 Trench Width 36" Max Trench Bottom Depth 36" Gravel Depth 12"

☑ New System ☐ Repair System Type: I, (II), III, IV, V, VI
System Description: CONVENTIONAL GRAVITY
Repair System Description: PUMP 25% REDUCTION
Maintenance Agreement Required: ☐ Yes ☑ No


☑ House/Mod. Home No. Bedrooms 3
☐ Mobile Home No. Bathrooms
☐ Business No. Employees
☐ Other
☐ Slab ☐ Crawl Space ☐ Basement w/plumbing ☑ Basement wo/plumbing

Water Supply: ☑ Individual ☐ Public ☐ Community


Comments:/Conditions: (1) INSTALL ON CONTOUR (2) MAINTAIN SETBACKS (3) INSTALL SUBSURFACE INTERCEPTOR DRAIN 48" ~~DEEP~~ TO DAYLIGHT

Comments:/Conditions: ZABEL FILTER & MARKER INSTALLED AS DRAWN

1" = 100' 350' INITIAL SITE SKETCH

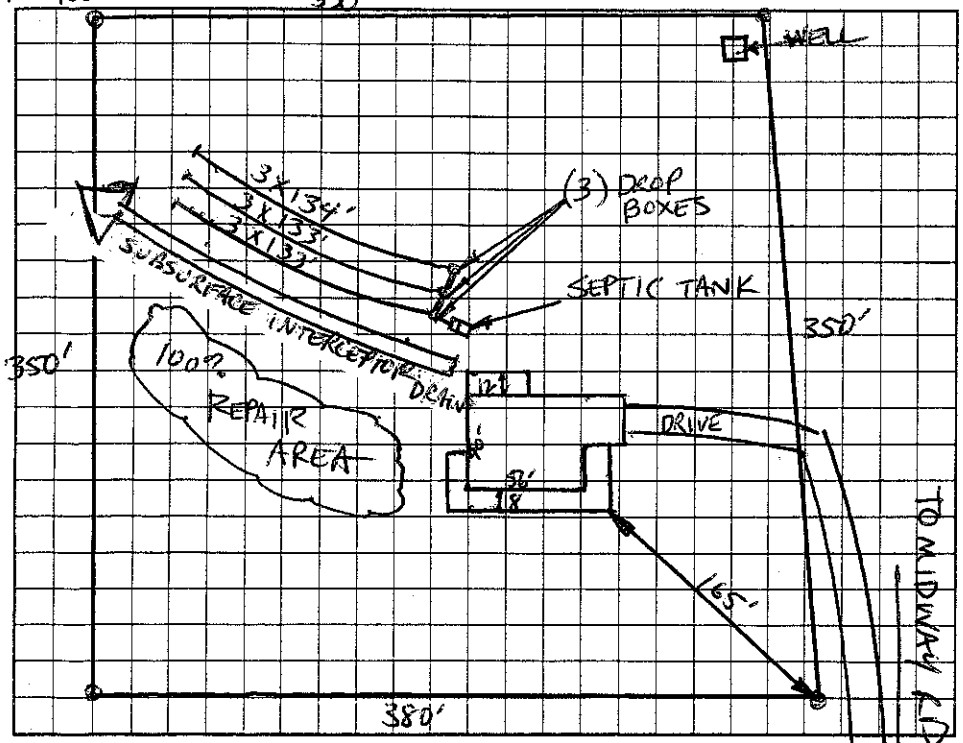

AS BUILT SKETCH

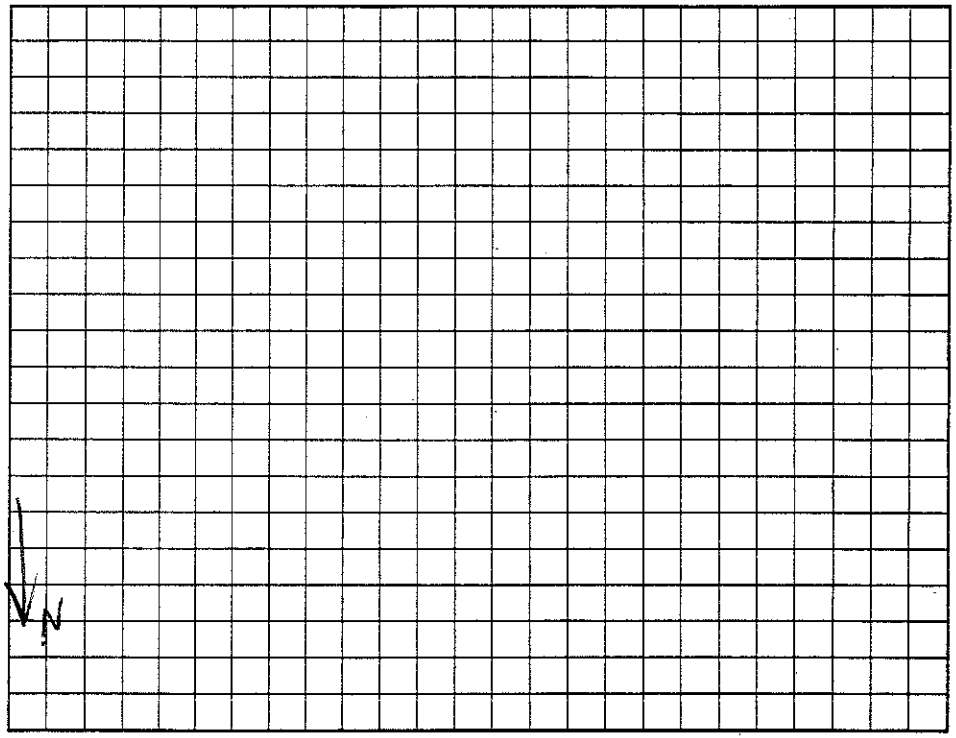

Permit can be suspended or revoked if any false information is supplied toward securing the permit/any unauthorized changes are made to the site/any unauthorized changes are made in the installation of the system. Improvement Permit with plat valid without expiration. Improvement Permit with site plan valid for sixty months. Authorization to Construct is valid for a period equal to that of Improvement Permit – not to exceed sixty months.

Signed: Clyde Fedder date 12-17-04 Installed by: Tommy (OTHER)

Improvement Permit by: Christopher M. Smith RS date 12-15-04 Operation Permit by: Clyde Fedder date 10-5-05

Authorization to Construct by: Christopher M. Smith RS date 12-17-04 Existing System Inspection by: date

HEALTH DEPT. COPY: WHITE OWNER COPY (FINAL): YELLOW OWNER COPY (INITIAL): PINK