10.00

IREDELL COUNTY HEALTH DEPARTMENT

STATESVILLE 704-878-5305 MOORESVILLE 704-664-5281

IMPROVEMENT PERMIT / AUTHORIZATION TO CONSTRUCT / OPERATION PERMIT / EXISTING SYSTEM INSPECTION

PERMIT# REPAIR PIN# DATE 12-1-98

OWNER OR CONTRACTOR HAL BROWN PHONE: Business Home 585-2329

ADDRESS 1371 MIDWAY ROAD, STONY POINT NC 28678

LOCATION NC 115 N, TL MIDWAY ROAD, 2ND HOUSE ON LEFT PAST RANDOLPH FARM ROAD

SUBDIVISION BLOCK / SECTION LOT LOT AREA ACREAGE SITE CLASS PS DESIGN FLOW 360 LTAR EXISTING

Septic Tank: EXISTING Gallons: STB Date

Pump Tank: Gallons: PT Date

Pump Make: Model: Serial No.

Nitrification Field: No. Fields: 1 Square Feet: 300 Linear Feet: 100

No. Lines: ONE Trench Width: 36" Max. Trench Bottom Depth: 36" Trench Depth: 18"

New System: ✓ Repair System Type: 01

System Description:

Repair System Description: CONVENTIONAL GRAVITY

Manufacturer Approved Repairs: Yes ✓ No

Other:


Soil Profile & Evaluation by: Assessment w/plumbing

House/Mod. Home: ✓ Mobile Home: No. Bedrooms: 3 No. Bathrooms: 2 No. Employees:

Water Supply: ✓ Individual ☐ Public ☐ Community: WELL

Comments/Conditions: NOTICE OF VIOLATION THIS PERMIT SERVES AS

INITIAL SITE SKETCH

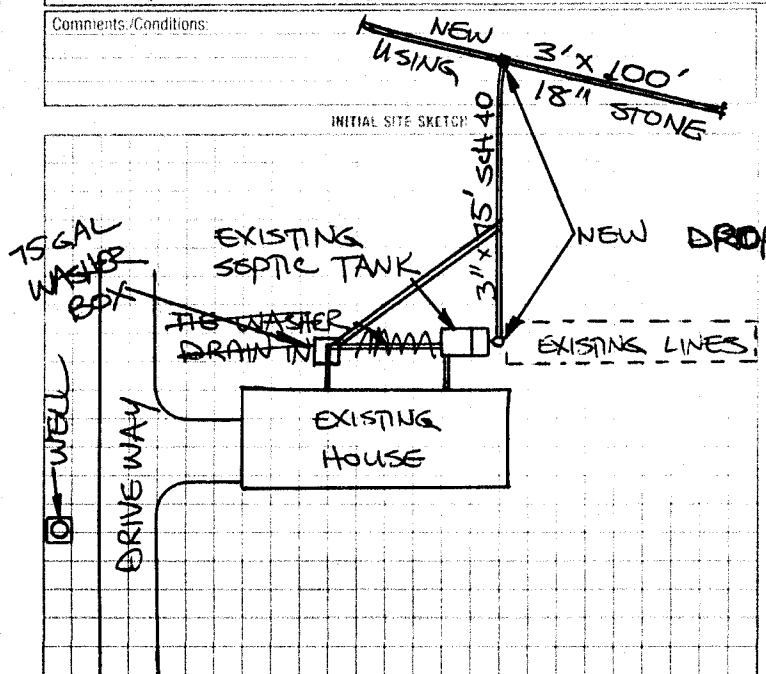

AS BUILT SKETCH

Installed as shown.

I understand that this permit can be suspended or revoked if any false information is supplied toward securing the permit/any unauthorized changes are made to the site/any unauthorized changes are made in the installation of the system. Improvement Permit with plat valid without expiration. Improvement Permit with site plan valid for sixty months. Authorization to Construct is valid for a period equal to that of Improvement Permit – not to exceed sixty months.

MIDWAY ROAD (SR 1554 W)

Signed: Hal Brown date

Improvement Permit by: STEVE HEDRICK date 12-1-98

Authorization to Construct by: STEVE HEDRICK date 12-1-98

Installed by: James Hudler

Operation Permit by: Mark C. Offt date 2-12-99

Existing System Inspection by: OK date

HEALTH DEPT. COPY: WHITE INSPECTION COPY (FINAL): GREEN OWNER COPY (FINAL): YELLOW INSPECTION COPY (INITIAL): PINK OWNER COPY (INITIAL): GOLD