IREDELL COUNTY HEALTH DEPARTMENT

STATESVILLE 704-878-5305 MOORESVILLE 704-664-5281

IMPROVEMENT PERMIT / AUTHORIZATION TO CONSTRUCT / OPERATION PERMIT / EXISTING SYSTEM INSPECTION

PERMIT# 91560 PIN# 4707533591 DATE 8-30-00

OWNER OR CONTRACTOR Nelson Dellinger Bldg Co. PHONE: Business 871 2672 Home

ADDRESS 125 Grace Lynn Dr. Statesville N.C.

LOCATION 115N TL midway Dr. TL Randolph Farm Rd 1/4mi Rt.

SUBDIVISION BLOCK / SECTION LOT LOT AREA 1.0 acres SITE CLASS P3 DESIGN FLOW 360 L.T.A.R. 1.3

Septic Tank: 1000 Gallons: STB 794 Date 4-14-01
Pump Tank: Gallons: PT Date
Pump Make: Model Serial No.
Nitrification Field: No Fields 1 Square Feet 900 Linear Feet 300
No Lines 6 Trench Width 36" Max Trench Bottom Depth 36" Gravel Depth N/A

☑ New System ☐ Repair System Type: I II III IV V VI
System Description: Gravity 25% Reduc
Repair System Description: Pump To 25% Reduc
Maintenance Agreement Required: ☐ Yes ☑ No


☑ House/Mod Home ☐ Mobile Home ☐ Business ☐ Other
No. Bedrooms 3 No. Bathrooms 2 No. Employees
☐ Slab ☑ Crawl Space ☐ Basement w/plumbing ☐ Basement wo/plumbing

Water Supply: ☑ Individual ☐ Public ☐ Community


Comments/Conditions:

Comments/Conditions: - Poly Lok Filter Installed
- Septic Tank Marker Installed
- Installed as per Initial Site Sketch.

INITIAL SITE SKETCH

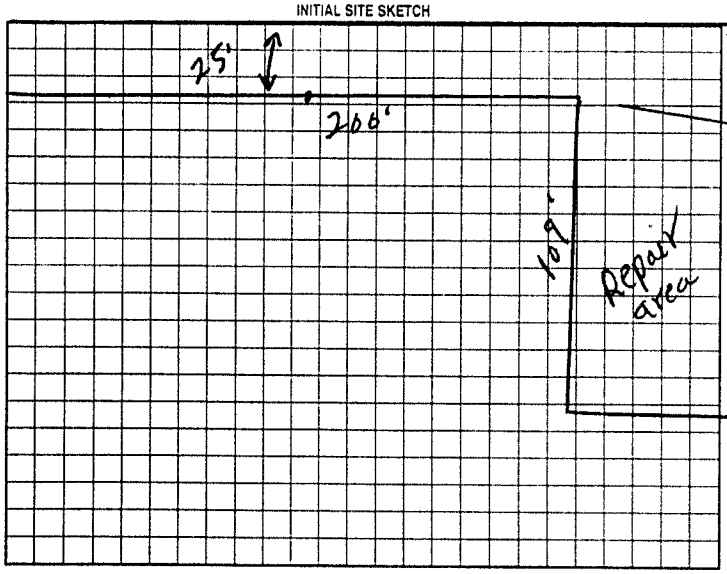

AS BUILT SKETCH

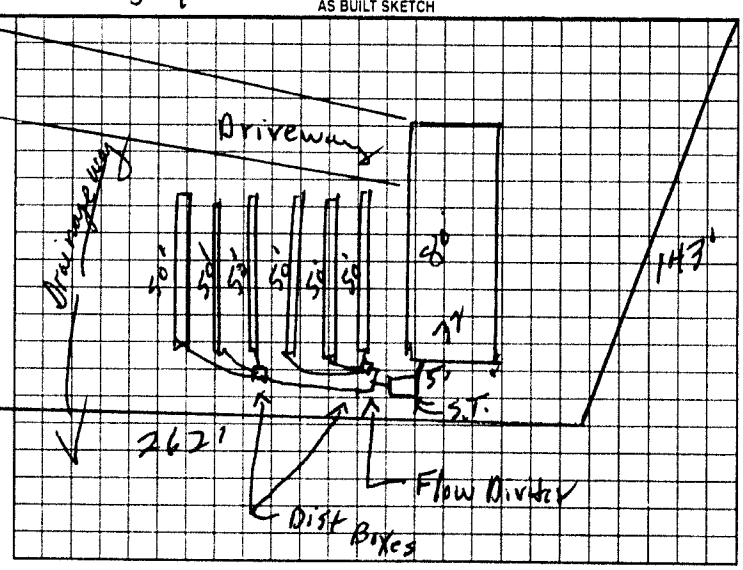

Permit can be suspended or revoked if any false information is supplied toward securing the permit/any unauthorized changes are made to the site/any unauthorized changes are made in the installation of the system. Improvement Permit with plat valid without expiration. Improvement Permit with site plan valid for sixty months. Authorization to Construct is valid for a period equal to that of Improvement Permit - not to exceed sixty months.

Signed: Nelson Dellinger date 8-30-00 Installed by: Craig Thompson

Improvement Permit by: R.C. Moore date 8-30-00 Operation Permit by: William G Johnson date 5/17/01

Authorization to Construct by: R.C. Moore date 8-30-00 Existing System Inspection by: date

HEALTH DEPT. COPY: WHITE OWNER COPY (FINAL): YELLOW OWNER COPY (INITIAL): PINK

Randolph Rd