FYFE

IREDELL COUNTY HEALTH DEPARTMENT

STATESVILLE 704-878-5305 MOORESVILLE 704-664-5281

53864

IMPROVEMENT PERMIT / CERTIFICATE OF COMPLETION / OPERATION PERMIT / EXISTING SYSTEM INSPECTION

PROPERTY DESCRIPTION NO. 19867 DATE 12/7/94 TAX MAP NO. 90-3-A-1

OWNER OR CONTRACTOR GARY FYFE PHONE: Business 881-1989 Home 876-4359 Watershed: ☐ Yes ☑ No

ADDRESS 1110 JANE SOWERS RD STATESVILLE NC 28677

LOCATION NC 90 W, TL MIDWAY ROAD, TL ABNER DRIVE, ~0.5 MILE ON RIGHT

SUBDIVISION QUAIL POINT BLOCK / SECTION 1 LOT #1 LOT AREA 5.91 AC SITE CLASS PS DESIGN FLOW 360 L.T.A.R. 0.05 GPD/FT²

Septic Tank: 1000 Gallons; STB 1012 Date 2/16/95

Pump Tank: ____ Gallons; PT ____ Date ____

Pump Make: ____ Model ____ Serial No. ____

Nitrification Field: No Fields 1 Square Feet 1035 Linear Feet 345

No Lines 4 Trench Width 36" Max Trench Bottom Depth 18-36" Gravel Depth 12"

☑ New System ☐ Repair System Type: I, II, III, IV, V, VI

System Description: CONVENTIONAL GRAVITY

Repair System Description: CONV. GRAVITY

Maintenance Agreement Required: ☐ Yes ☑ No

☐ Slab ☑ Crawl Space ☐ Basement w/plumbing ☐ Basement wo/plumbing

☑ House/Mod. Home No. Bedrooms 3

☐ Mobile Home No. Bathrooms 2

☐ Business No. Employees ____


☐ Other ____

Water Supply: ☑ Individual ☐ Community ☐ Public WELL


Comments: ① KEEP SYSTEM MINIMUM 5' FROM HOUSE 10' FROM PROPERTY LINE, 100' FROM WELL. ② INSIDE LINES ON CONTOUR NO DEEPER THAN 36", 9' MINIMUM ON CENTER

Comments:

INITIAL SITE SKETCH

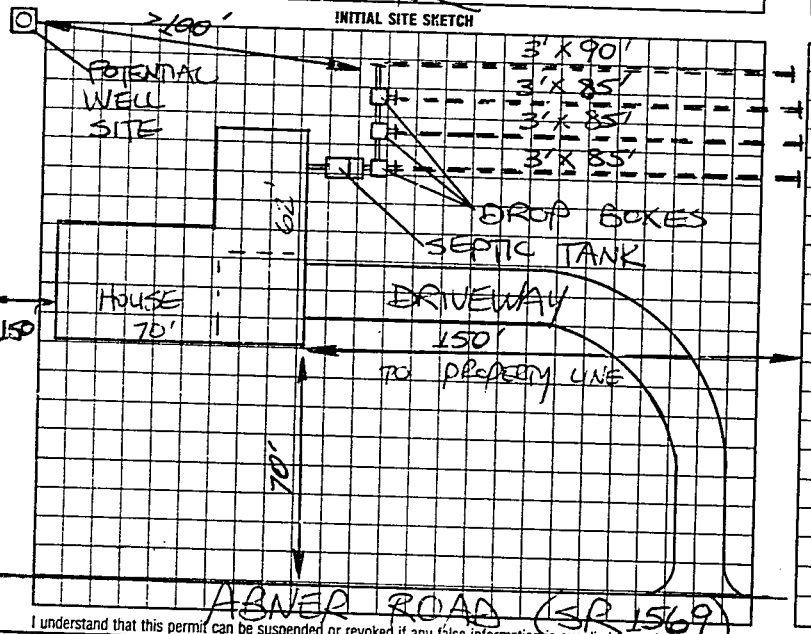

AS BUILT SKETCH

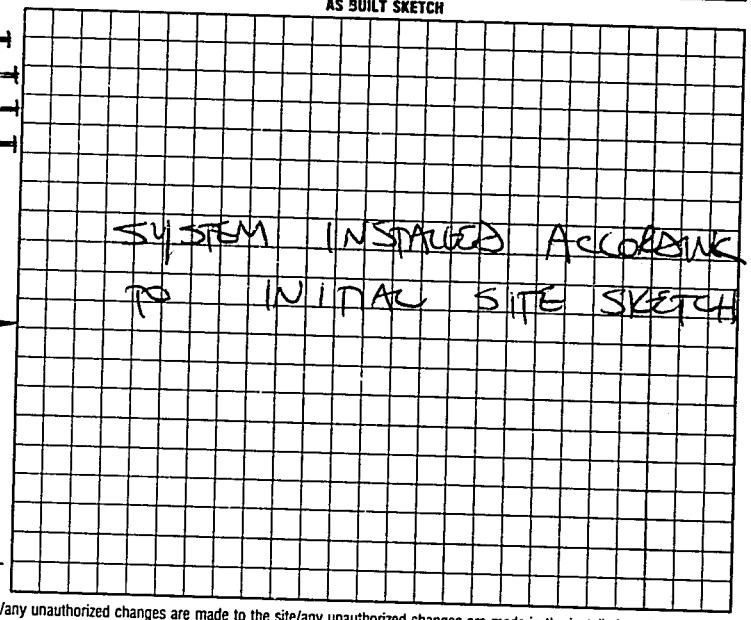

I understand that this permit can be suspended or revoked if any false information is supplied toward securing the permit/any unauthorized changes are made to the site/any unauthorized changes are made in the installation of the system. Improvement Permit is valid for 60 months from date of issuance.

Signed: Henry D Nicholson

Improvement Permit by: STEVE HEDRICK date 12/7/94

Existing System Inspection by: ____ date ____

Installed by: TOMMY FYFE

Certificate of Completion by: STEVE HEDRICK date 5/1/95

Operation Permit by: ____ date ____

HEALTH DEPT COPY: WHITE INSPECTION COPY (FINAL) GREEN OWNER COPY (FINAL): YELLOW INSPECTION COPY (INITIAL): PINK OWNER COPY (INITIAL): GOLD