IREDELL COUNTY HEALTH DEPARTMENT

STATESVILLE 704-878-5305 (C) MOORESVILLE 704-664-5281

IMPROVEMENT PERMIT / AUTHORIZATION TO CONSTRUCT / OPERATION PERMIT / EXISTING SYSTEM INSPECTION

PERMIT# 122423 PIN# 4707-66-7195 DATE 7/16/04

OWNER OR CONTRACTOR Susan Simpson PHONE: Business - Home (704) 585-6108

ADDRESS 186 Blueche Lane Stony Point N.C 28678

LOCATION 115 North (L) midway Drive, (R) Abner Rd (R) Blueche Lane, cross creek on left

SUBDIVISION _____ BLOCK / SECTION _____ LOT _____ LOT AREA 3.25 Ac SITE CLASS. #5 DESIGN FLOW _____ L.T.A.R. _____

Septic Tank: 1000 Gallons; STB 1007 Date 8-9-04
Pump Tank: _____ Gallons; PT _____ Date _____
Pump Make: _____ Model _____ Serial No. _____
Nitrification Field: No Fields 1 Square Feet 1200 Linear Feet 400
No Lines 4 Trench Width 36" Max Trench Bottom Depth 30" Gravel Depth 12"

☒ New System ☐ Repair System Type: I (II) III, IV, V, VI
System Description: Gravity Conventional
Repair System Description: Gravity, 25% Reduction
Maintenance Agreement Required: ☐ Yes ☒ No

☐ House/Mod. Home ☒ Mobile Home ☐ Business ☐ Other
No. Bedrooms 3 No. Bathrooms ____ No. Employees ____


☐ Slab ☒ Crawl Space ☐ Basement w/plumbing ☐ Basement wo/plumbing

Water Supply: ☒ Individual ☐ Public ☐ Community

Comments:/Conditions: (1) Install Lines on Contour

Comments:/Conditions: SEPTIC TANK WITH MARKER INSTALLED USING "ZABEL" FILTER

INITIAL SITE SKETCH (Not to Scale)

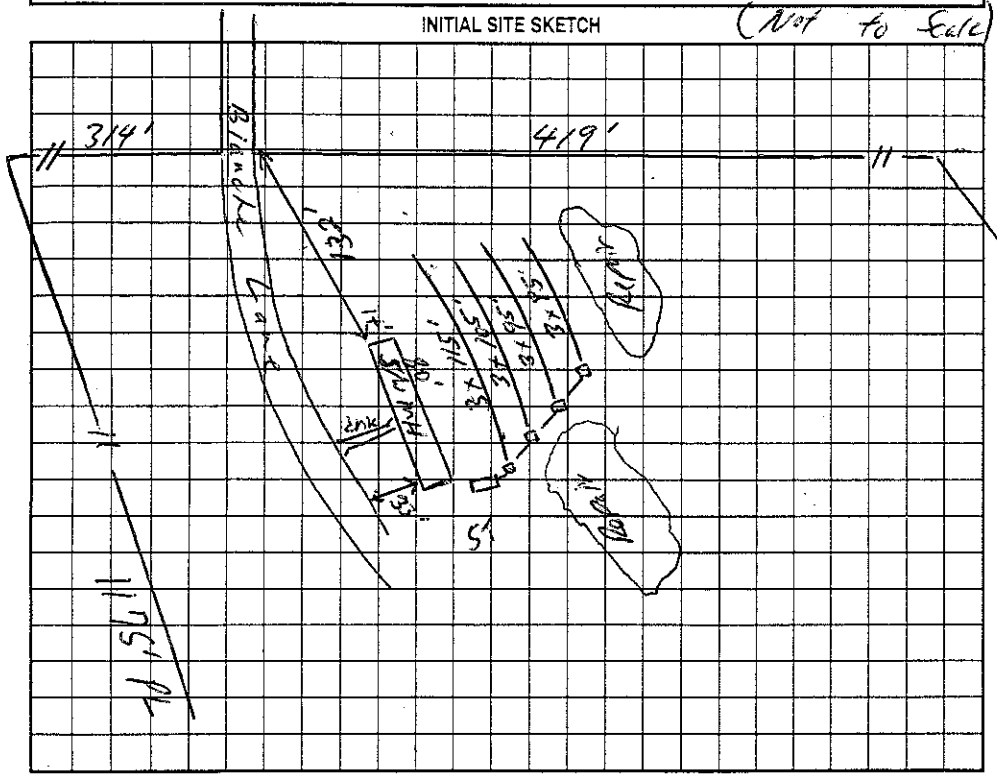

AS BUILT SKETCH

SYSTEM INSTALLED ACCORDING TO INITAL SITE SKETCH

Permit can be suspended or revoked if any false information is supplied toward securing the permit/any unauthorized changes are made to the site/any unauthorized changes are made in the installation of the system. Improvement Permit with plat valid without expiration. Improvement Permit with site plan valid for sixty months. Authorization to Construct is valid for a period equal to that of Improvement Permit – not to exceed sixty months.

Signed: Julie Bohan date 7-16-04 Installed by: IREDELL BACKHOE

Improvement Permit by: William A Johnson date 7/16/04 Operation Permit by: STEVE HEDRICK date 10.4.04

Authorization to Construct by: William A Johnson date 7/16/04 Existing System Inspection by: _____ date _____

HEALTH DEPT. COPY: WHITE OWNER COPY (FINAL): YELLOW OWNER COPY (INITIAL): PINK