# IREDELL COUNTY HEALTH DEPARTMENT

STATESVILLE 704-878-5305 MOORESVILLE 704-664-5281

## IMPROVEMENT PERMIT / AUTHORIZATION TO CONSTRUCT / OPERATION PERMIT / EXISTING SYSTEM INSPECTION

PERMIT# Repair PIN# 4797-72-8849 BOX # 119 DATE 8/26/04

OWNER OR CONTRACTOR David Poag PHONE: Business (704) 585-6619 Home —

ADDRESS 1223 Midway Rd Statesville N.C. 28625

LOCATION Hwy 115 N, (L) Midway Rd, (L) Antrim Rd, (L) Diggits Dr, Last House on Lane

SUBDIVISION — BLOCK / SECTION — LOT 119 LOT AREA 2.05 Ac. SITE CLASS. PS DESIGN FLOW 360 L.T.A.R. Ex

Septic Tank: 75 Gallons; STB — Date —

Pump Tank: — Gallons; PT — Date —

Pump Make: — Model — Serial No. —

Nitrification Field: No Fields 1 Square Feet 300 Linear Feet 80

No Lines 3 Trench Width 36 Max Trench Bottom Depth 36" Gravel Depth 15"

☐ New System ☒ Repair System Type: I, II, III, IV, V, VI

System Description: —

Repair System Description: Gravity, Conventional

Maintenance Agreement Required: ☐ Yes ☐ No

☐ House/Mod. Home No. Bedrooms 3

☒ Mobile Home No. Bathrooms —

☐ Business No. Employees —

☐ Other —

☐ Slab ☒ Crawl Space ☐ Basement w/plumbing ☐ Basement wo/plumbing


Water Supply: ☒ Individual ☐ Public ☐ Community

well

Comments:/Conditions: ① Install 75 gallon box with 80 Ft of line (3 lines) to accept sink drain only ② This permit serves as N.O.V. owner has thirty (30) days to correct.

Comments:/Conditions:

INITIAL SITE SKETCH (Not to Scale)

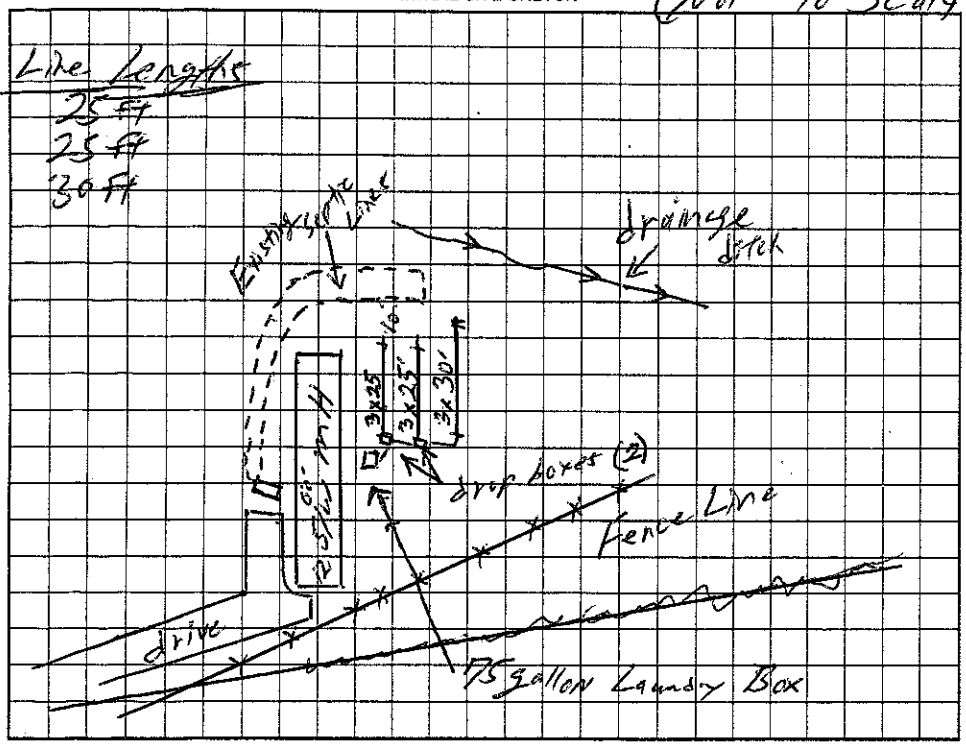


AS BUILT SKETCH

System installed according to initial site sketch

Permit can be suspended or revoked if any false information is supplied toward securing the permit/any unauthorized changes are made to the site/any unauthorized changes are made in the installation of the system. Improvement Permit with plat valid without expiration. Improvement Permit with site plan valid for sixty months. Authorization to Construct is valid for a period equal to that of Improvement Permit – not to exceed sixty months.

Signed: W.E. Douglas 8-26-04 date — Installed by: Forest Stuffers

Improvement Permit by: William O. Johnson date 8/26/04 Operation Permit by: Steve Herrick date 9-15-04

Authorization to Construct by: William O. Johnson date 8/26/04 Existing System Inspection by: — date —

HEALTH DEPT. COPY: WHITE OWNER COPY (FINAL): YELLOW OWNER COPY (INITIAL): PINK