IREDELL COUNTY HEALTH DEPARTMENT

THIS PERMIT VOIDS PREVIOUS ISSUED 6-26-98

STATESVILLE 704-878-5305 MOORESVILLE 704-664-5281

IMPROVEMENT PERMIT / AUTHORIZATION TO CONSTRUCT / OPERATION PERMIT / EXISTING SYSTEM INSPECTION

PERMIT# 074337 PIN# 4709 74 0834 DATE 9-21-99

OWNER OR CONTRACTOR DAVID A. MOOSE PHONE: Business Home 585-6568

ADDRESS 1284 MIDWAY ROAD, STATESVILLE, NC 28625

LOCATION NC 115 N, TL MIDWAY ROAD, ON RIGHT ~4.5 MILES AT BOX # 1284

SUBDIVISION BLOCK / SECTION LOT LOT AREA 35.8 ACRES SITE CLASS PS DESIGN FLOW 360 L.T.A.R 0.33 GPD/FT²

Septic Tank: 1000 Gallons; STB 1012 Date 11-8-99

Pump Tank: Gallons; PT Date

Pump Make: Model Serial No.

Nitrification Field: No Fields 1 Square Feet 1080 Linear Feet 360

No Lines THREE Trench Width 36" Max Trench Bottom Depth 36" Gravel Depth 12"

✓ New System ☐ Repair System Type: I II III IV V VI

System Description: CONV. GRAVITY

Repair System Description: CONV. GRAVITY

Maintenance Agreement Required: ☐ Yes ☐ No

☐ Slab ☐ Crawl Space ✓ Basement w/plumbing ☐ Basement wo/plumbing

✓ House/Mod. Home No. Bedrooms 3

☐ Mobile Home No. Bathrooms 3

☐ Business No. Employees


☐ Other

Water Supply: ✓ Individual ☐ Public ☐ Community WELL


Comments/Conditions:

Comments/Conditions:

INITIAL SITE SKETCH

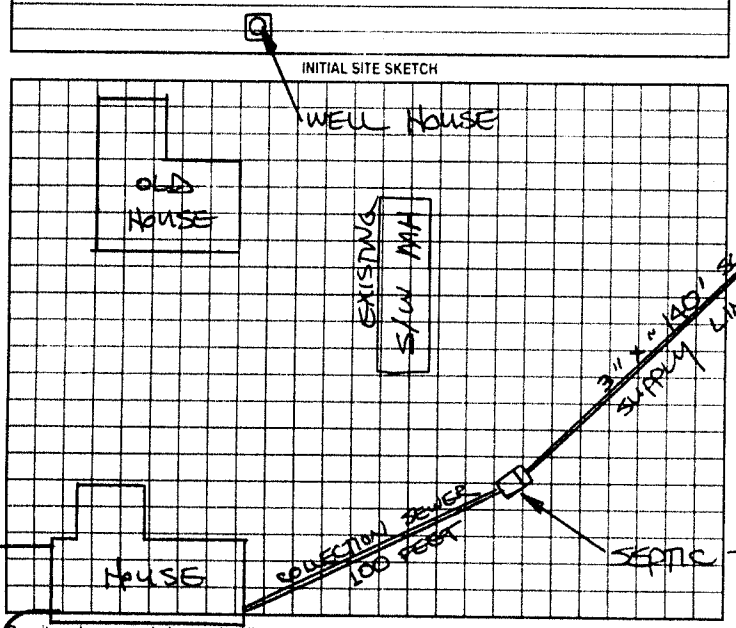

AS BUILT SKETCH

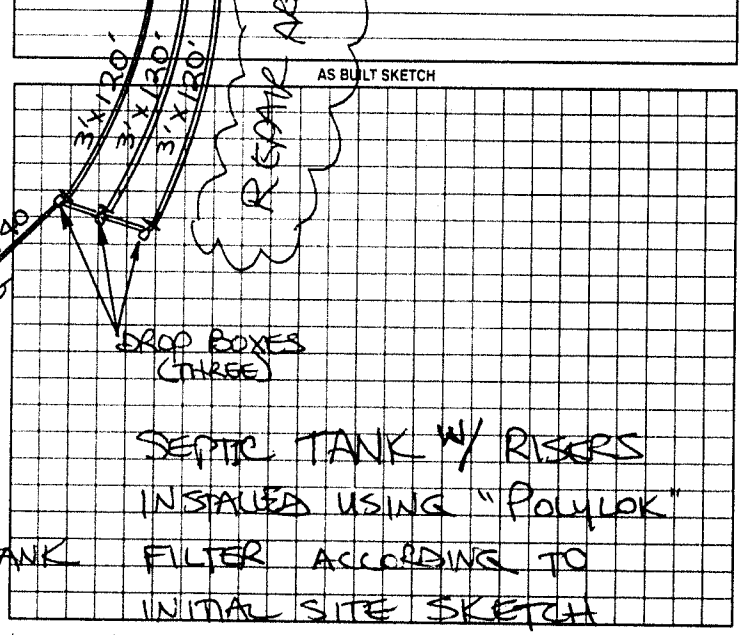

Permit can be suspended or revoked if any false information is supplied toward securing the permit/any unauthorized changes are made to the site/any unauthorized changes are made in the installation of the system. Improvement Permit with plat valid without expiration. Improvement Permit with site plan valid for sixty months. Authorization to Construct is valid for a period equal to that of Improvement Permit – not to exceed sixty months.

Signed: David A. Moose date 9-22-99 Installed by STEVE JORDAN

Improvement Permit by: STEVE HEDRICK date 9-21-99 Operation Permit by: STEVE HEDRICK date 3-2-00

Authorization to Construct by: STEVE HEDRICK date 9-21-99 Existing System Inspection by: date

HEALTH DEPT COPY WHITE OWNER COPY (FINAL) YELLOW OWNER COPY (INITIAL) PINK