IREDELL COUNTY HEALTH DEPARTMENT

Statesville Phone TR 3-7271 . Mooresville Phone No. 664-5281

PERMIT TO INSTALL SEPTIC TANK

Permit No. _____ Permit Date 8-17 1973

Owner Troy Mosse Address Statesville N.C.

Installed By Harlie Lackey Address Stony Point N.C.


Location of Property Hwy #90 to Scotts. T.R. on Rd # 1562 Go to Rd 1554 (Midway Drive) T.L. Go approx ½ Mile. House on R. Back off of Road.

Tank		Capacity		Length of Lines		Fixtures	
Block	( )	1000	(✓)	225'	(✓)	No. of Baths	(1)
Precast	(✓)	1250	( )	250'	( )	Dishwasher	( )
		1500	( )	Other _____		Garbage Grdr.	( )
		Other _____				Other _____	

NOTIFY HEALTH DEPARTMENT AT LEAST EIGHT HOURS BEFORE TANK IS TO BE INSPECTED.

Final Inspection 8-17 1973 Approved (✓) Disapproved ( )

Remarks Well 53' away

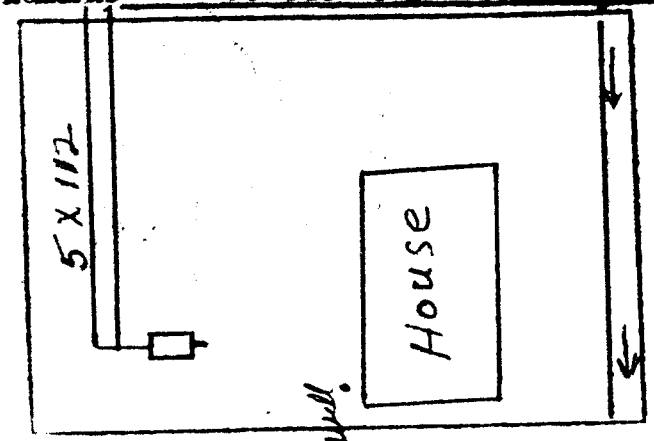

Sketch of Installation

E. A. Stevenson

Sanitarian