IREDELL COUNTY HEALTH DEPARTMENT

Statesville Phone TR 3-7271 Mooresville Phone NO 3-1271

PERMIT TO INSTALL SEPTIC TANK

Permit No. _____ Permit Date 9-15 1964

Owner FLOYD ADAMS Address _____

Installed By FLOYD ADAMS Address _____


Location of Property ONE MILE ONE WAY DRIVE PASS DOUBLINS HOMES & MIDWAY CH. 1st Road TO RIGHT

Tank		Capacity		Length of Lines		Fixtures	
Block	( )	1000	(✓)	225'	( )	No. of Baths	(1½)
Precast	(X)	1250	( )	250'	( )	Dishwasher	( )
		1500	( )	Other _____		Garbage Grdr.	( )
		Other _____				Other _____	

NOTIFY HEALTH DEPARTMENT AT LEAST EIGHT HOURS BEFORE TANK IS TO BE INSPECTED.

Final Inspection 9-15 1964 Approved (✓) Disapproved ( )

Remarks _____

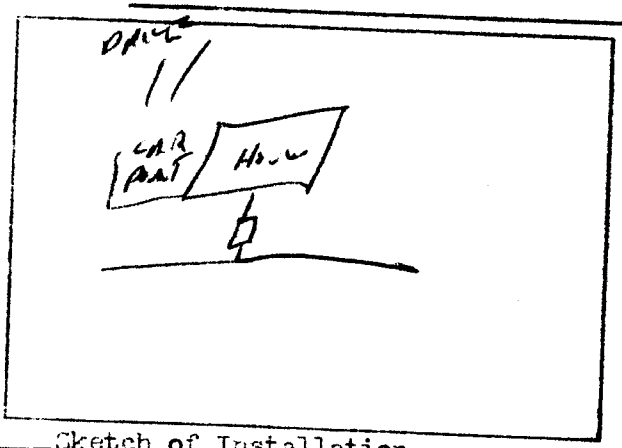

Sketch of Installation

RS

Sanitarian