IREDELL COUNTY HEALTH DEPARTMENT

STATESVILLE 704-878-5305 MOORESVILLE 704-664-5281

IMPROVEMENT PERMIT / AUTHORIZATION TO CONSTRUCT / OPERATION PERMIT / EXISTING SYSTEM INSPECTION

PERMIT# 80423 PIN# 4707894951 DATE 4-7-99

OWNER OR CONTRACTOR Murray Lyerly PHONE: Business _____ Home 892 6844

ADDRESS 147 Mt Mourne Ln Mooresville

LOCATION Midway (R) Above on Right Next 1mile

SUBDIVISION _____ BLOCK / SECTION _____ LOT _____ LOT AREA _____ SITE CLASS P5 DESIGN FLOW 360 L.T.A.R. .35

Septic Tank: 1000 Gallons; STB 900 Date 9/099

Pump Tank: _____ Gallons; PT _____ Date _____

Pump Make: _____ Model _____ Serial No. _____

Nitrification Field: No Fields 1 Square Feet 1028 Linear Feet 350

No Lines 4 Trench Width 36" Max Trench Bottom Depth 36" Gravel Depth 12"

☒ New System ☐ Repair System Type: I ☐ II, IV, V, VI

System Description: Conv. Repair

Repair System Description: Conv Repair

Maintenance Agreement Required: ☐ Yes ☒ No

☐ Slab ☒ Crawl Space ☐ Basement w/plumbing ☐ Basement wo/plumbing

☒ House/Mod. Home No. Bedrooms 3

☐ Mobile Home No. Bathrooms 2

☐ Business No. Employees _____

☐ Other _____


Water Supply: ☒ Individual ☐ Public ☐ Community

Well


Comments/Conditions: Install Lines on Contour
Remove Terraces if needed

Comments/Conditions:

INITIAL SITE SKETCH

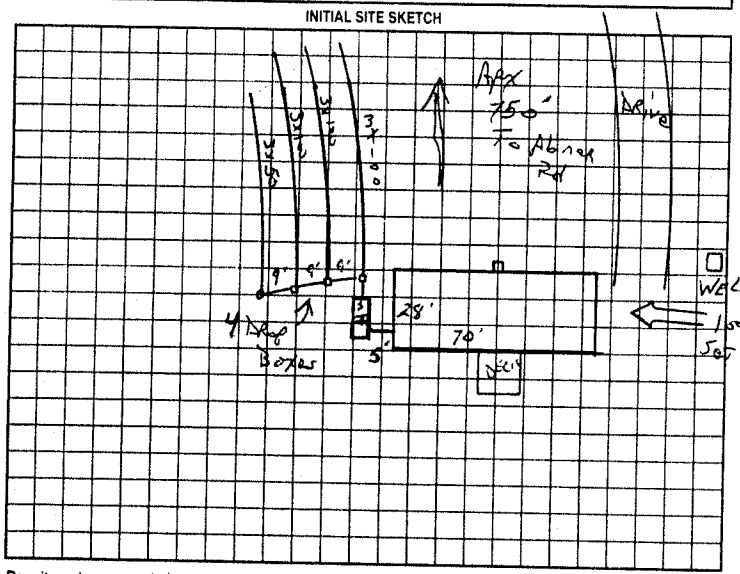

AS BUILT SKETCH

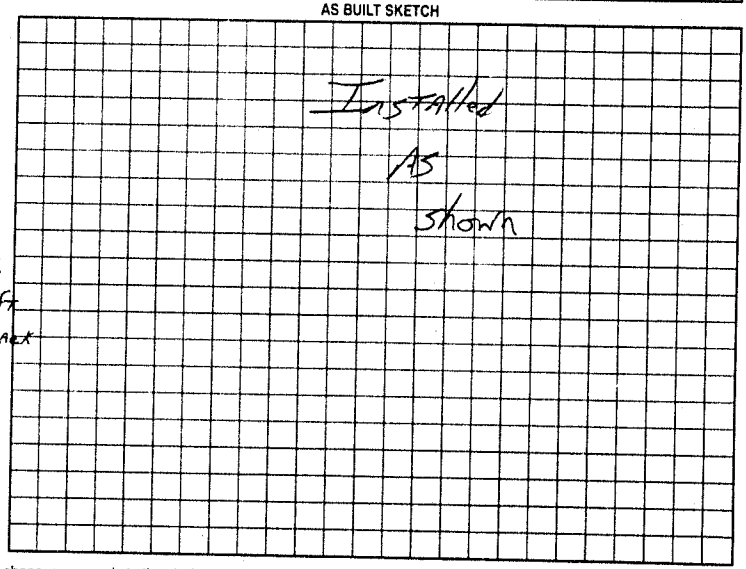

Permit can be suspended or revoked if any false information is supplied toward securing the permit/any unauthorized changes are made to the site/any unauthorized changes are made in the installation of the system. Improvement Permit with plat valid without expiration. Improvement Permit with site plan valid for sixty months. Authorization to Construct is valid for a period equal to that of Improvement Permit – not to exceed sixty months.

Signed: Murray Lyerly date 4-7-99

Improvement Permit by: C Potter date 4.7.99

Authorization to Construct by: C Potter date 4.7.99

Installed by: Wayne Clontz

Operation Permit by: C Potter date Oct 19 99

Existing System Inspection by: _____ date _____

HEALTH DEPT COPY: WHITE OWNER COPY (FINAL) YELLOW OWNER COPY (INITIAL) PINK