IREDELL COUNTY HEALTH DEPARTMENT

STATESVILLE 704-878-5305 MOORESVILLE 704-664-5281

IMPROVEMENT PERMIT / AUTHORIZATION TO CONSTRUCT / OPERATION PERMIT / EXISTING SYSTEM INSPECTION

PERMIT# 124305 PIN# 4707-89-~~4957~~ 5945 DATE 9-29-04

OWNER OR CONTRACTOR MURRAY LYERLY PHONE: Business _____ Home (704) 585-2860

ADDRESS 400 ABNER RD. STONY POINT NC 28678

LOCATION 115N TL MIDWAY TR ABNER 1.5 MI ON RT JUST PAST RED BARN

SUBDIVISION _____ BLOCK / SECTION _____ LOT _____ LOT AREA _____ SITE CLASS. PS DESIGN FLOW 360 L.T.A.R. .35 EX

Septic Tank: 1000 EX Gallons; ST8 _____ Date _____

Pump Tank: _____ Gallons; PT _____ Date _____

Pump Make: _____ Model _____ Serial No. _____

Nitrification Field: No Fields 1 Square Feet _____ Linear Feet 350 EX

No Lines 4 EX. Trench Width 36" Max Trench Bottom Depth 36" Gravel Depth EX.

☐ New System ☐ Repair System Type: I, (II), III, IV, V, VI

System Description: CONVENTIONAL GRAVITY

Repair System Description: _____

Maintenance Agreement Required: ☐ Yes ☑ No

☑ House/Mod. Home No. Bedrooms 3

☐ Mobile Home No. Bathrooms _____

☐ Business No. Employees _____

☐ Other _____


☑ Slab ☐ Crawl Space ☐ Basement w/plumbing ☐ Basement wo/plumbing

Water Supply: ☑ Individual ☐ Public ☐ Community WELL


Comments:/Conditions:

Comments:/Conditions:

INITIAL SITE SKETCH

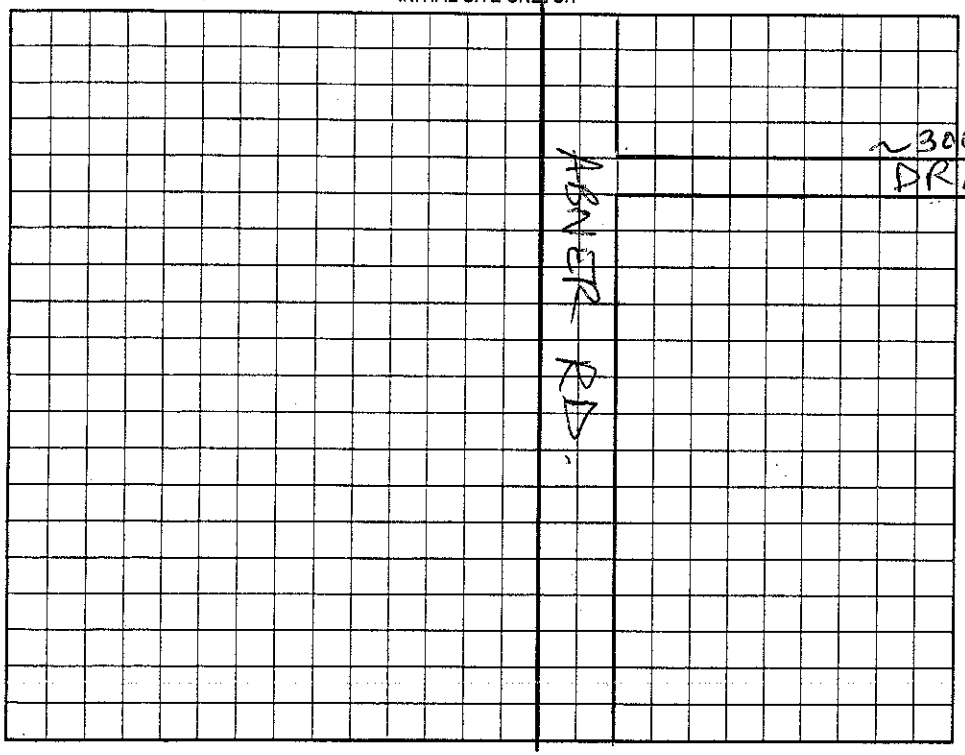

AS BUILT SKETCH SCALE 1" = 60'

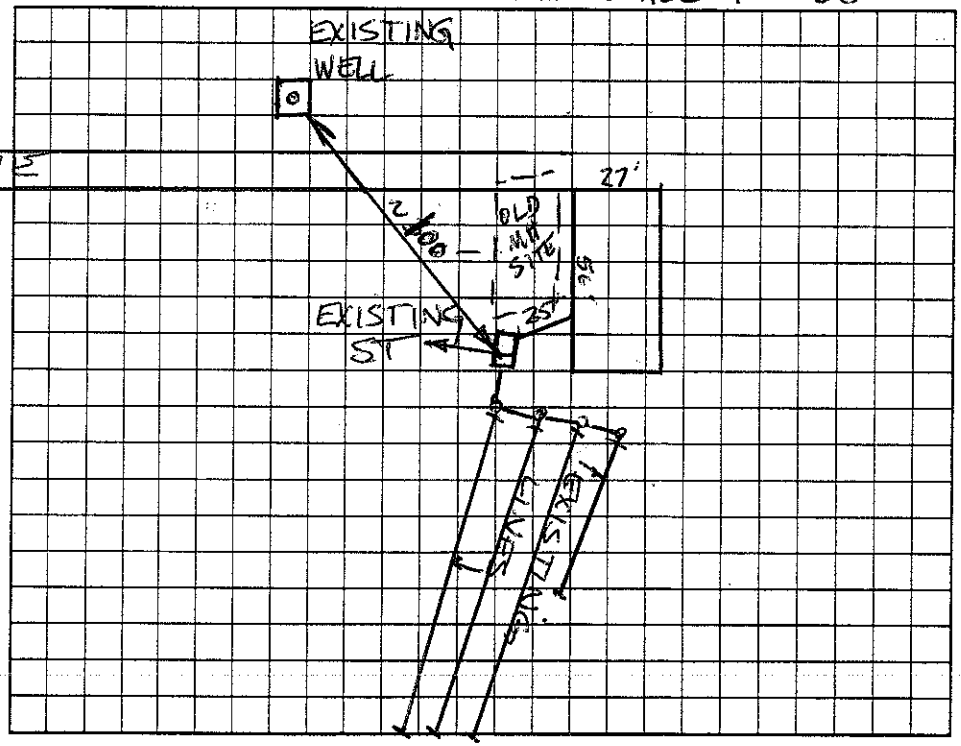

Permit can be suspended or revoked if any false information is supplied toward securing the permit/any unauthorized changes are made to the site/any unauthorized changes are made in the installation of the system. Improvement Permit with plat valid without expiration. Improvement Permit with site plan valid for sixty months. Authorization to Construct is valid for a period equal to that of Improvement Permit – not to exceed sixty months.

Signed: _____ date 9-30-2004 Installed by: WAYNE CLONTZ

Improvement Permit by: _____ date _____ Operation Permit by: _____ date _____

Authorization to Construct by: _____ date _____ Existing System Inspection by: _____ date 9-29-04

HEALTH DEPT. COPY: WHITE OWNER COPY (FINAL): YELLOW OWNER COPY (INITIAL): PINK