IREDELL COUNTY HEALTH DEPARTMENT - *ENVIRONMENTAL HEALTH* ☐ STATESVILLE OFFICE 704-878-5305 ☐ MOORESVILLE OFFICE 704-664-5281

IMPROVEMENT PERMIT / AUTHORIZATION TO CONSTRUCT / OPERATION PERMIT / EXISTING SYSTEM INSPECTION

PERMIT # 167818 PIN # 4707-94-5257 DATE 02 August 2011

OWNER Tom Conger APPLICANT: PHONE: Home/Cell # (240) 277-4432 Business #

~~SITE ADDRESS~~ ~~102 Liberty Hill Rd. Statesville~~ OWNER / APPLICANT ADDRESS

SITE DIRECTIONS 115 N TL Midway Rd. TR Liberty Hill Rd. on RT.

SUBDIVISION BLOCK / SECTION LOT # LOT AREA 13 Ac. DESIGN FLOW 360 g/d L.T.A.R. 0.3 g/Ft²d

1130 Midway Rd

Septic Tank 1000 Gallons: STB 1012 Date 1-16-11

Pump Tank Gallons: PT Date

Pump Make Model Serial #

No. Nitrification Fields: 1 No. Lines 4 Linear Feet 400

Trench Width 36" Max. Trench Bottom Depth 36" Gravel Depth 12"

☑ New System ☐ Repair ☐ Expansion System Type I II III IV V VI

System Description: Conventional / gravel

Repair System Description: Conventional / gravel

Maintenance Agreement Required ☐ YES ☒ NO

☑ GRAVITY ☐ PRESSURE

☑ Residence No. Bedrooms 3

☐ Business No. Persons

☐ Other No. Employees

☐ Slab ☐ Crawl Space

☑ Basement w/plumbing ☐ Basement w/o plumbing

Water Supply: ☑ Private ☐ Public ☐ Community

Comments / Conditions


An Accepted system may be utilized instead of Conventional / gravel.

* Keep well 100' from system and repair area.


ST has marker

Polylock Filter

INITIAL SITE SKETCH

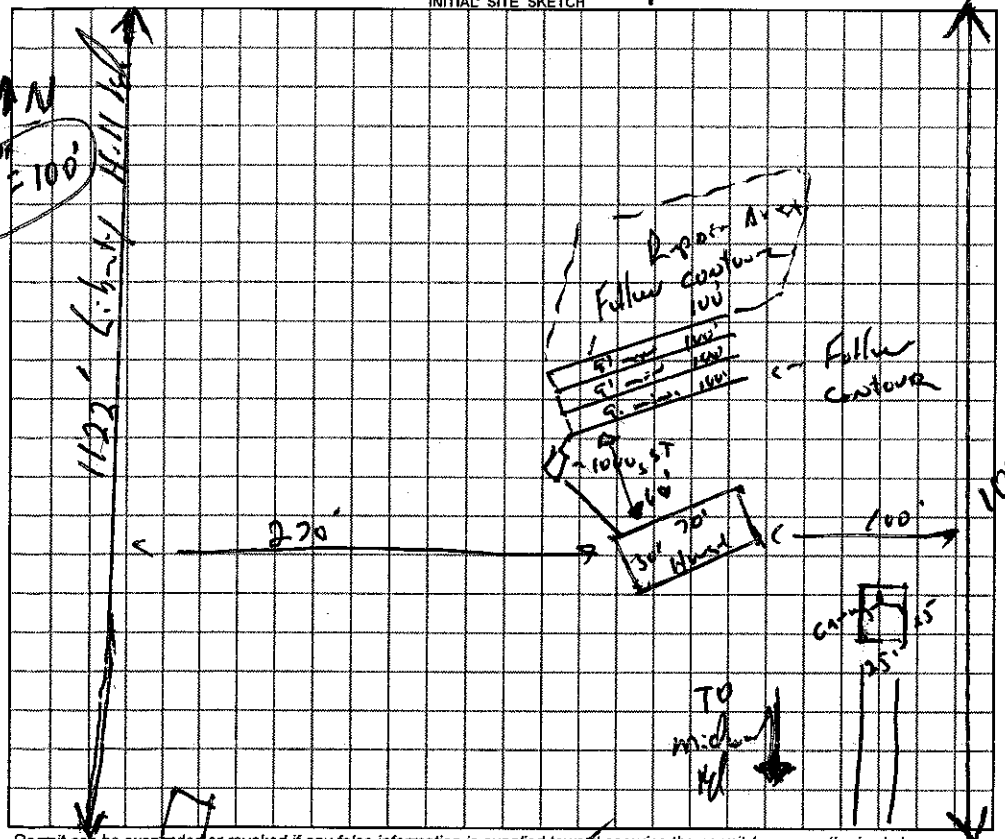

AS BUILT SKETCH

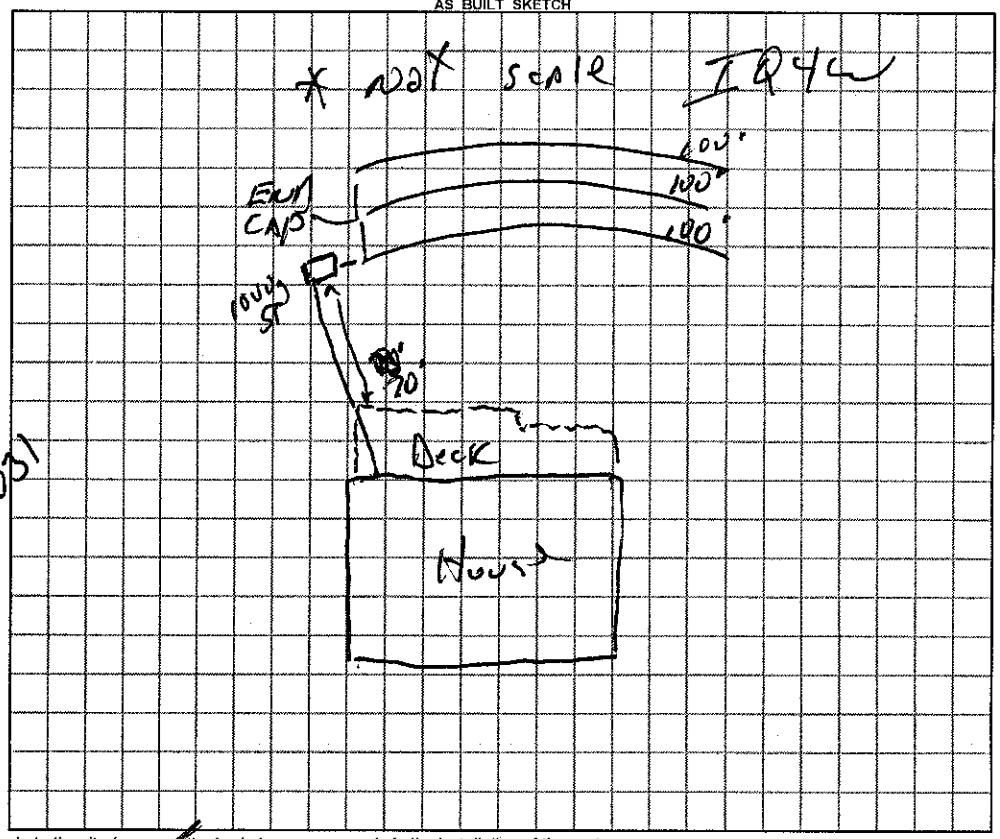

Permit can be suspended or revoked if any false information is supplied toward securing the permit / any unauthorized changes are made to the site / any unauthorized changes are made in the installation of the system.

☐ ~~*IMPROVEMENT PERMIT with plat valid without expiration.*~~ ☑ ~~*IMPROVEMENT PERMIT with plat valid without expiration.*~~ *site plan valid 60 mo.* ☑ *AUTHORIZATION TO CONSTRUCT* valid for period equal to IMPROVEMENT PERMIT--not to exceed 60 mo.

Owner / Applicant Signature: Tom Conger Date 15-10-11 Installed by: Bowman Farms 4119

IMPROVEMENT PERMIT by: REHS Date 22 Aug 11 OPERATION PERMIT by: REHS Date 18 Jan. 12

AUTHORIZATION TO CONSTRUCT by: REHS Date 22 Aug 11 Existing System Inspected by: REHS Date

YOU SHOULD CONTACT A LOCATOR SERVICE PRIOR TO ANY EXCAVATION

White Copy – Environmental Health YELLOW COPY (Final) Owner / Applicant PINK COPY (Initial) Owner / Applicant