IREDELL COUNTY HEALTH DEPARTMENT - *ENVIRONMENTAL HEALTH* ☐ STATESVILLE OFFICE 704-878-5305 ☐ MOORESVILLE OFFICE 704-664-5281

IMPROVEMENT PERMIT / AUTHORIZATION TO CONSTRUCT / OPERATION PERMIT / EXISTING SYSTEM INSPECTION

PERMIT # Repair PIN # 4707957525 DATE 5-21-12

OWNER Joe Goodin APPLICANT: Same PHONE: Home/Cell # 704-585-2101 Business # 704-585-9300

SITE ADDRESS 188 Liberty Hill Rd. OWNER / APPLICANT ADDRESS 188 Liberty Hill Rd. Statesville NC 28625

SITE DIRECTIONS Hwy 115 N; L on Midway Rd; R on Liberty Hill Rd; 1st Brick House on right

SUBDIVISION N/A BLOCK / SECTION N/A LOT # N/A LOT AREA 1.52 acres DESIGN FLOW 360 gpd L.T.A.R. 0.25

Septic Tank Grising Gallons: STB Date

Pump Tank Gallons: P T Date

Pump Make Model Serial #

No. Nitrification Fields: 1 No. Lines 4 Linear Feet 360'

Trench Width 36" Max. Trench Bottom Depth 36" Gravel Depth N/A

☐ New System ☑ Repair ☐ Expansion System Type I II (III) IV V VI

System Description: N/A

Repair System Description: 25% Reduction

Maintenance Agreement Required ☐ YES ☑ NO

☑ GRAVITY ☐ PRESSURE

☑ Residence No. Bedrooms 3

☐ Business No. Persons

☐ Other No. Employees


☐ Slab ☐ Crawl Space

☑ Basement w/plumbing ☐ Basement w/o plumbing


Water Supply: ☑ Private ☐ Public ☐ Community

Comments / Conditions: Install 25% Reduction on Contour w/ Serial distribution; Remove any trees necessary to install; Plumb washing machine t sink into septic tank; Inspect septic tank integrity, replace if needed.

INITIAL SITE SKETCH

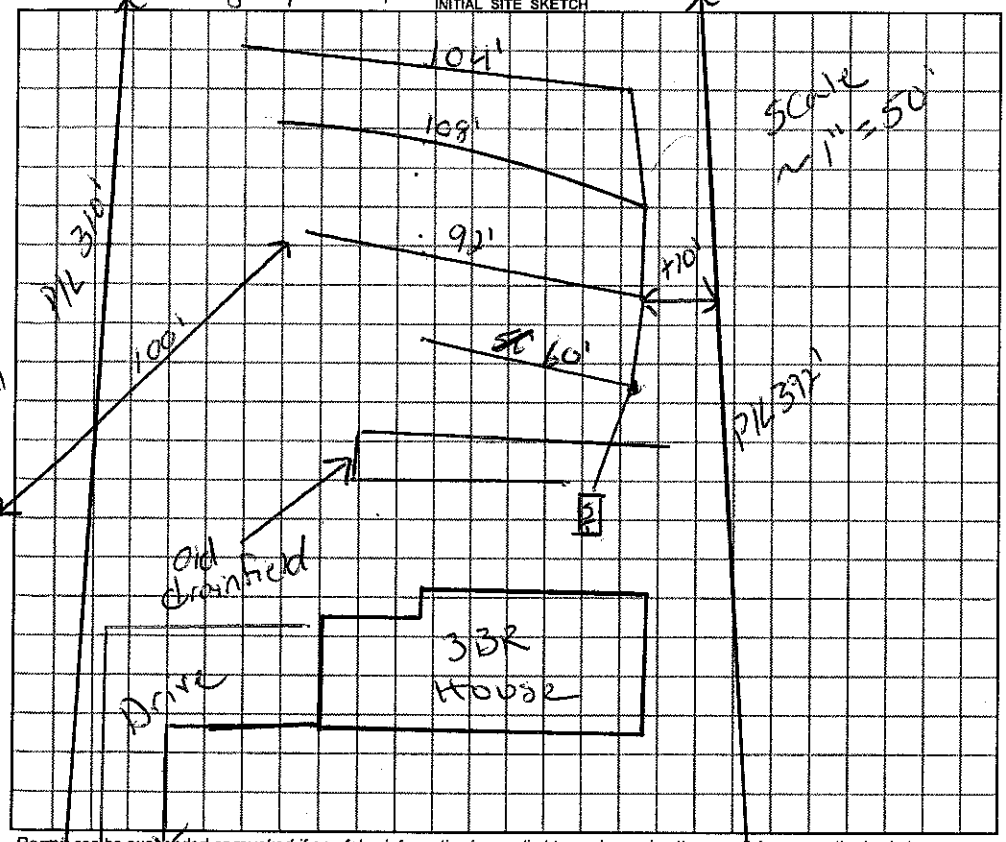

AS BUILT SKETCH

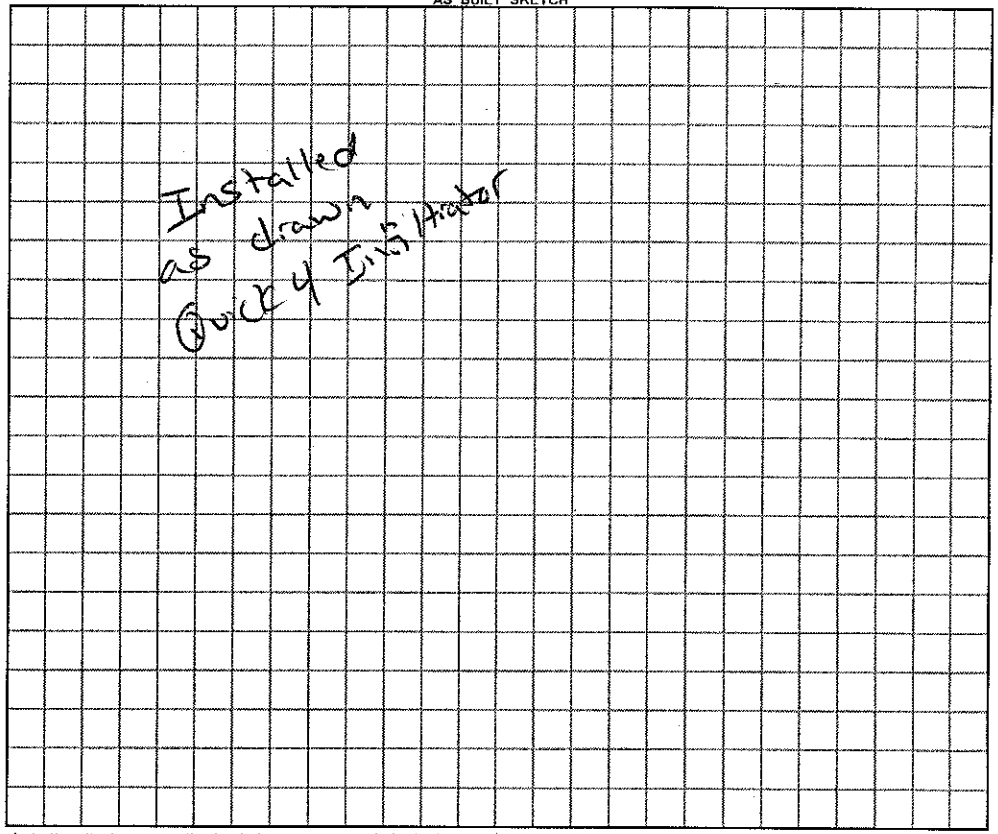

Permit can be suspended or revoked if any false information is supplied toward securing the permit / any unauthorized changes are made to the site / any unauthorized changes are made in the installation of the system.

☐ *IMPROVEMENT PERMIT with plat valid without expiration.* ☑ *IMPROVEMENT PERMIT with plat ~~valid without expiration~~ site plan valid 60 mo.* ☑ *AUTHORIZATION TO CONSTRUCT* valid for period equal to IMPROVEMENT PERMIT–not to exceed 60 mo.

Owner / Applicant Signature: Joe E Goodin Date 5-22-12 Installed by: James Hudgins

IMPROVEMENT PERMIT by: Justin Henderson REHS Date 5-21-12 OPERATION PERMIT by: James REHS Date 6-19-12

AUTHORIZATION TO CONSTRUCT by: Justin Henderson REHS Date 5-21-12 Existing System Inspected by: REHS Date

YOU SHOULD CONTACT A LOCATOR SERVICE PRIOR TO ANY EXCAVATION

White Copy – Environmental Health YELLOW COPY (Final) Owner / Applicant PINK COPY (Initial) Owner / Applicant