IREDELL COUNTY HEALTH DEPARTMENT

Statesville Phone TR 3-7271 Mooresville Phone NO 3-1271

PERMIT TO INSTALL SEPTIC TANK

Permit No. 210 Permit Date 8-25 1969

Owner Carl E. Gordon Address RFD 8 City

Installed By H. L. Hedrick Address Statesville, NC


Location of Property Hwy 64, Rt South on Central Sch. Rd. Left on Midway Dr., new house on Rt below Lindsay House

Tank		Capacity		Length of Lines		Fixtures	
Block	( )	1000	(✓)	225'	(✓)	No. of Baths	( )
Precast	( )	1250	( )	250'	( )	Dishwasher	( )
		1500	( )	Other		Garbage Grdr.	( )
		Other				Other	

NOTIFY HEALTH DEPARTMENT AT LEAST EIGHT HOURS BEFORE TANK IS TO BE INSPECTED.

Final Inspection 8-25 1969 Approved (✓) Disapproved ( )

Remarks Near well on property

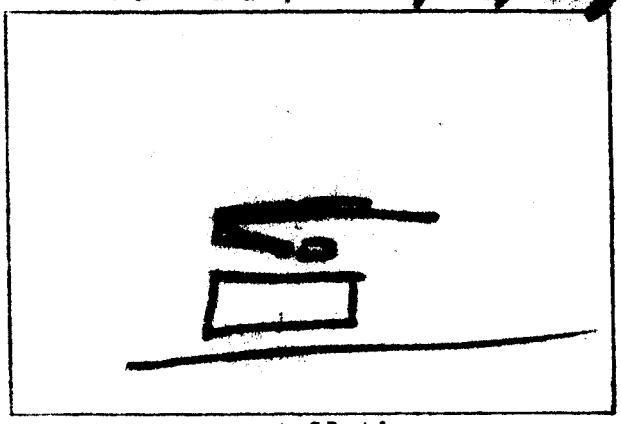

Sketch of Installation

Sanitarian