IREDELL COUNTY HEALTH DEPARTMENT

STATESVILLE 704-878-5305 MOORESVILLE 704-664-5281

IMPROVEMENT PERMIT / AUTHORIZATION TO CONSTRUCT / OPERATION PERMIT / EXISTING SYSTEM INSPECTION

PERMIT# 087301 PIN# 4709 10 5003 DATE 1-31-00

OWNER OR CONTRACTOR DAVID PEARR PHONE: Business 873-8964 Home 876-9036

ADDRESS 845 HARRIS BRIDGE ROAD, STONY POINT, NC 28678

LOCATION NC 115N, TL PISGAH ROAD, TL HARRIS BRIDGE ROAD, 1.1 MILE ON RIGHT AT BOX #845

SUBDIVISION _____ BLOCK / SECTION _____ LOT _____ LOT AREA 2.397 ACRES SITE CLASS PS DESIGN FLOW 480 L.T.A.R. 0.30 GPD/FT²

Septic Tank: 1000 Gallons; STB 1012 Date 1-4-2000
Pump Tank: _____ Gallons; PT _____ Date _____
Pump Make: _____ Model _____ Serial No. _____
Nitrification Field: No Fields 1 Square Feet 1600 Linear Feet 540
No Lines SIX Trench Width 36" Max Trench Bottom Depth 36" Gravel Depth 12"

☑ New System ☐ Repair System Type: I (II) III. IV. V. VI
System Description: CONVENTIONAL GRAVITY
Repair System Description: 25% REDUCTION GRAVITY
Maintenance Agreement Required: ☐ Yes ☑ No
☐ Slab ☑ Crawl Space ☐ Basement w/plumbing ☐ Basement wo/plumbing


☐ House/Mod. Home ☑ Mobile Home ☐ Business ☐ Other
No. Bedrooms 4 No. Bathrooms 2 No. Employees _____

Water Supply: ☐ Individual ☑ Public ☐ Community


Comments:/Conditions: USE ONE FLOW DIVIDER TEE TO ACHIEVE EQUAL DISTRIBUTION INTO EACH OF TWO DIST. BOXES FEEDING THREE LINES EACH

Comments:/Conditions: SEPTIC TANK WITH RISERS INSTALLED USING "POLYLOK" FILTER

INITIAL SITE SKETCH

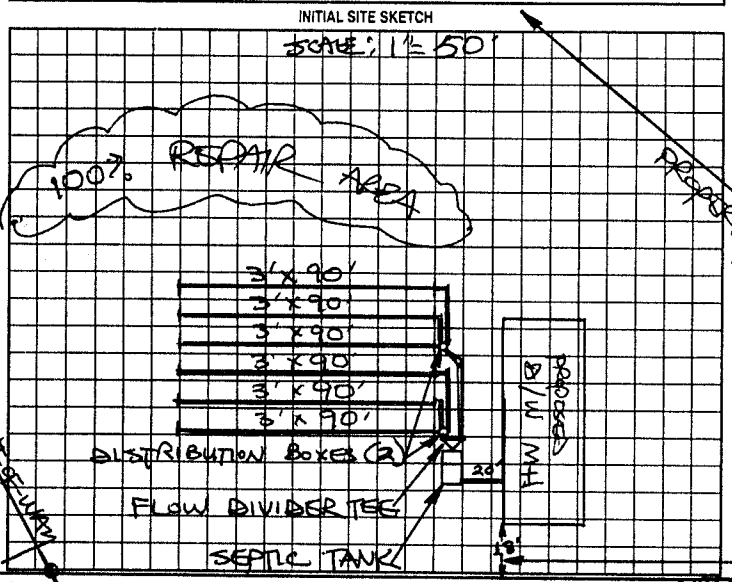

AS BUILT SKETCH

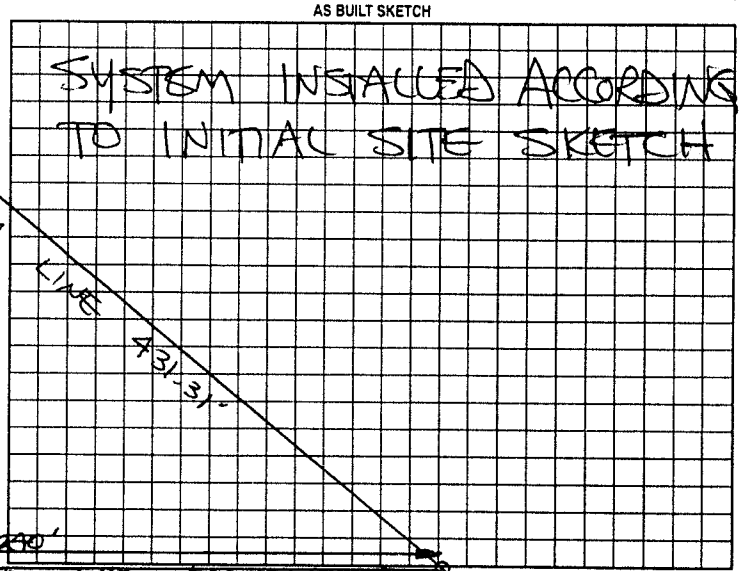

Permit can be suspended or revoked if any false information is supplied toward securing the permit/any unauthorized changes are made to the site/any unauthorized changes are made in the installation of the system. Improvement Permit with plat valid without expiration. Improvement Permit with site plan valid for sixty months. Authorization to Construct is valid for a period equal to that of Improvement Permit – not to exceed sixty months.

Signed: + David Pearr date 1-31-00 Installed by: A-1 BACKHOE

Improvement Permit by: STEVE HEDRICK date 1-31-00 Operation Permit by: STEVE HEDRICK date 5-3-00

Authorization to Construct by: STEVE HEDRICK date 1-31-00 Existing System Inspection by: _____ date _____

HEALTH DEPT. COPY: WHITE OWNER COPY (FINAL): YELLOW OWNER COPY (INITIAL): PINK