IREDELL COUNTY HEALTH DEPARTMENT - *ENVIRONMENTAL HEALTH* ☒ STATESVILLE OFFICE 704-878-5305 ☐ MOORESVILLE OFFICE 704-664-5281

IMPROVEMENT PERMIT / AUTHORIZATION TO CONSTRUCT / OPERATION PERMIT / EXISTING SYSTEM INSPECTION

PERMIT # Repair PIN # 4708201620 DATE 9/24/12

OWNER Lee Boggs APPLICANT: Same PHONE: Home/Cell # (704) 682-3848 Business #

SITE ADDRESS 329 Harris Bridge Road OWNER / APPLICANT ADDRESS

SITE DIRECTIONS Hwy 115 N → Midway Rd (L) → Harris Bridge (R) 329 on (L)

SUBDIVISION n/a BLOCK / SECTION n/a LOT # n/a LOT AREA 1.373 Ac DESIGN FLOW Ex L.T.A.R. Ex

Septic Tank 1000 Gallons: STB 760 Date 5-18-

Pump Tank ____ Gallons: P T ____ Date ____

Pump Make ____ Model ____ Serial # ____

No. Nitrification Fields: Ex No. Lines Ex Linear Feet Ex

Trench Width Ex Max. Trench Bottom Depth Ex Gravel Depth ____

☐ New System ☒ Repair ☐ Expansion System Type (II) III IV V VI

System Description: ____

Repair System Description: TANK.

Maintenance Agreement Required ☐ YES ☒ NO

☒ GRAVITY ☐ PRESSURE

☒ Residence No. Bedrooms 3

☐ Business No. Persons ____

☐ Other No. Employees ____


☐ Slab ☐ Crawl Space

☒ Basement w/plumbing ☐ Basement w/o plumbing


Water Supply: ☒ Private ☐ Public ☐ Community

Comments / Conditions

INITIAL SITE SKETCH

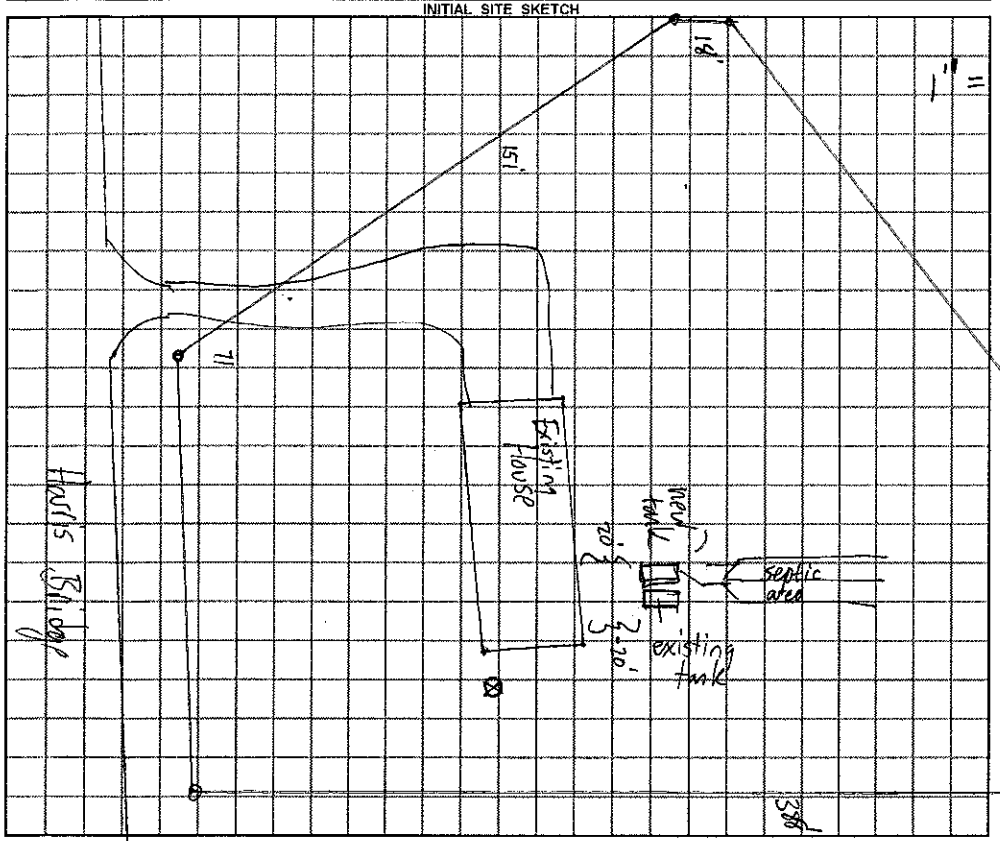

AS BUILT SKETCH

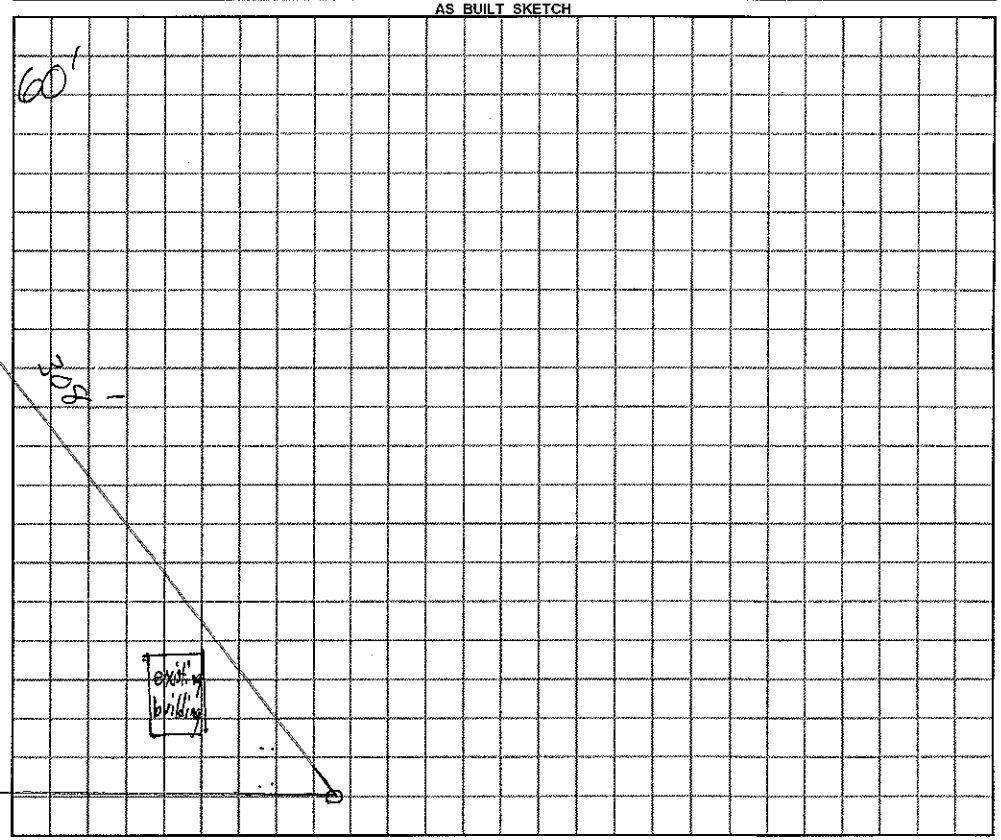

Permit can be suspended or revoked if any false information is supplied toward securing the permit / any unauthorized changes are made to the site / any unauthorized changes are made in the installation of the system.

☐ ***IMPROVEMENT PERMIT*** *with plat valid without expiration.* ☒ ***IMPROVEMENT PERMIT*** *with plat valid without expiration. site plan valid 60 mo.* ☒ ***AUTHORIZATION TO CONSTRUCT*** valid for period equal to IMPROVEMENT PERMIT--not to exceed 60 mo.

Owner / Applicant Signature: ____ Date 9/25/12 Installed by: Abee Grading

IMPROVEMENT PERMIT by: James REHS Date 9-24-12 OPERATION PERMIT by: James REHS Date 9-26-12

AUTHORIZATION TO CONSTRUCT by: James REHS Date 9-24-12 Existing System Inspected by: ____ REHS Date ____

YOU SHOULD CONTACT A LOCATOR SERVICE PRIOR TO ANY EXCAVATION

White Copy -- Environmental Health YELLOW COPY (Final) Owner / Applicant PINK COPY (Initial) Owner / Applicant