IREDELL COUNTY HEALTH DEPARTMENT

Statesville Office (704) 878-5305 Mooresville Office (704) 660-3625 PERMIT # 215197

IMPROVEMENT PERMIT / AUTHORIZATION TO CONSTRUCT / OPERATION PERMIT / EXISTING SYSTEM

PIN # 4708268149

APPLICANT: Keith Parsons APPLICANT ADDRESS: 167 Sojourner Ln.

SITE ADDRESS: 167 Sojourner Ln. PHONE: 704-876-3048 ALT. PHONE: N/A


SITE DIRECTIONS: Hwy 115N TL Midway TR Harris Bridge TL Sojourner Ln.

SUBDIVISION: N/A SECTION: N/A LOT # N/A LOT AREA: 1.517 acres DESIGN FLOW: 240gpd L.T.A.R.: Existing


Septic Tank	1500	(gal)	STB	964	Date	12-27-15	☐ New System	☑ Repair	☐ Expansion	System Type: I II (III) IV V VI	☑ Residence	No. Bedrooms	2	Water Supply			
Pump Tank	n/a	(gal)	PT	n/a	Date	n/a	System Description:	TANK			☐ Business	No. Persons	4	☑ Private			
Pump Make	n/a	Model	Poly/Flo		Serial #	PL-65	Repair System Description:				☐ Other	No. Employees		☐ Public			
# Nitrification Fields	6x	# Lines	6x		Linear Ft:	6x	Maintenance Agreement Required:	☐ YES	☑ NO		☐ Slab	☐ Crawl Space		☐ Community			
Trench Width	6x	Max. Trench Bottom Depth	6x		Gravel Depth	6x		☑ GRAVITY	☐ PRESSURE		☑ Basement w/plumbing			☐ Basement w/o plumbing			

Comments / Conditions: Pump & crush existing septic tank. Set new septic tank @ location shown below & connect to existing drainfield.

INITIAL SITE SKETCH

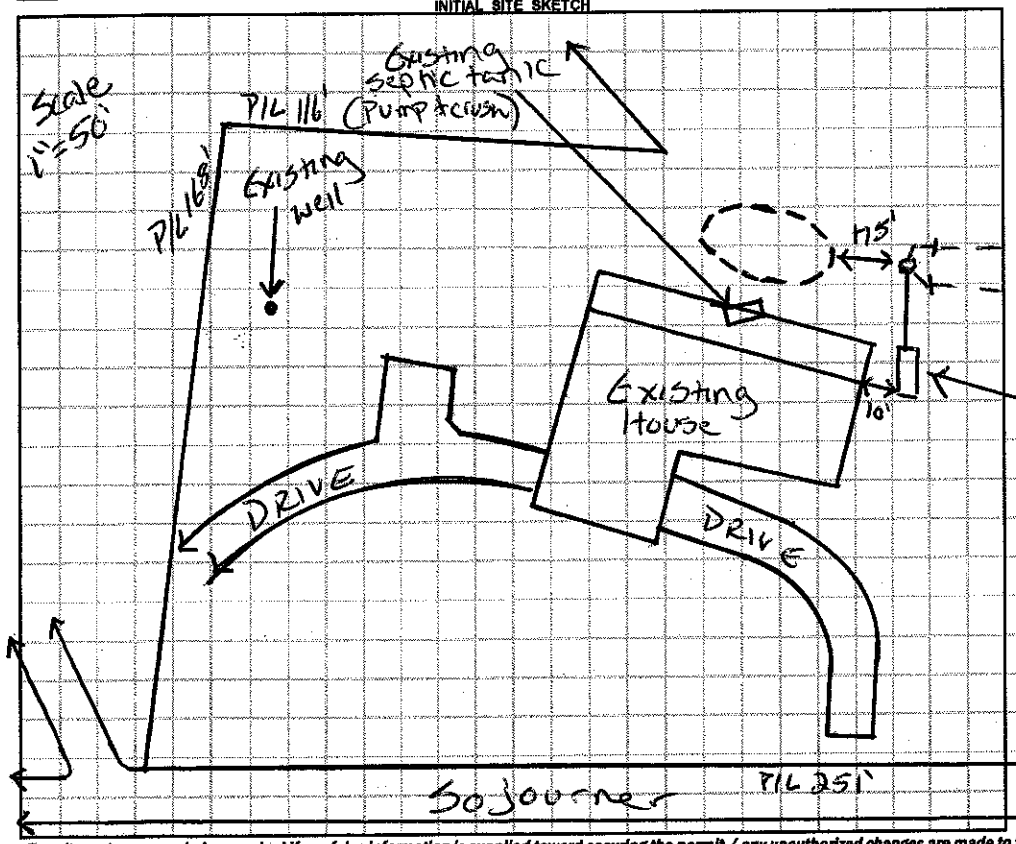

AS BUILT SKETCH

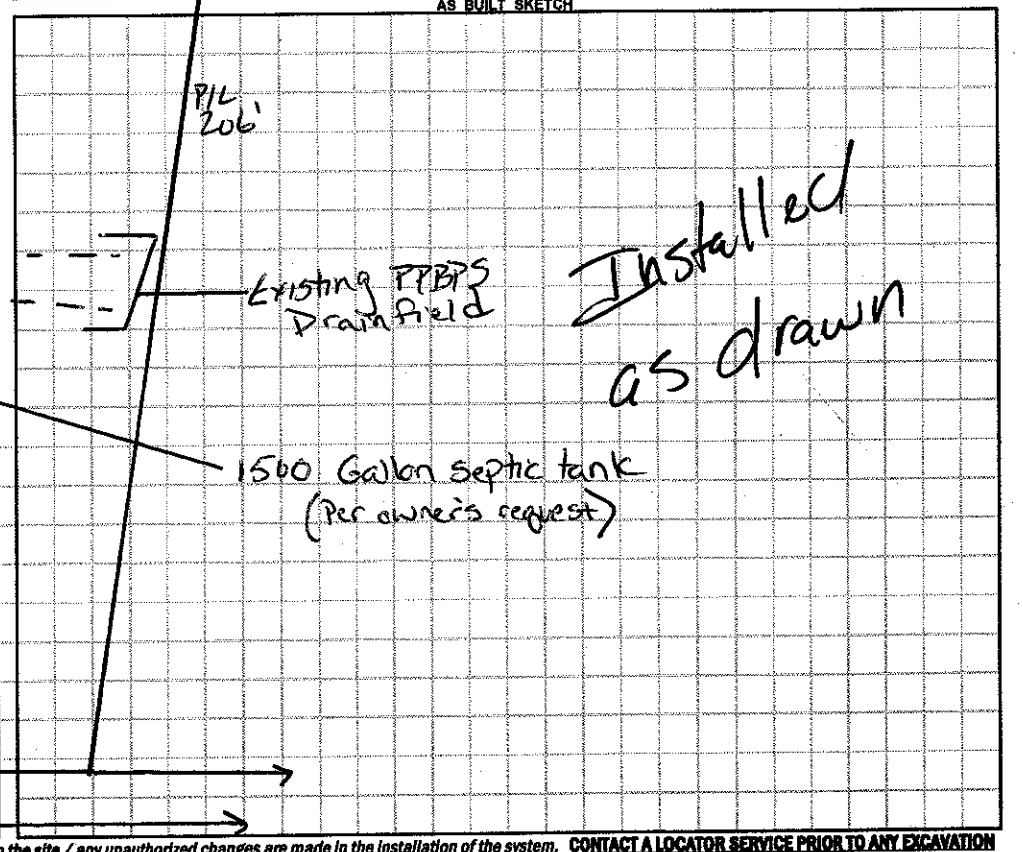

Permit can be suspended or revoked if any false information is supplied toward securing the permit / any unauthorized changes are made to the site / any unauthorized changes are made in the installation of the system. **CONTACT A LOCATOR SERVICE PRIOR TO ANY EXCAVATION**

☐ **IMPROVEMENT PERMIT** *with plat valid without expiration.* ☑ **IMPROVEMENT PERMIT** *with site plan valid for 60 mos.* ☑ **AUTHORIZATION TO CONSTRUCT** *valid for period equal to IMPROVEMENT PERMIT--not to exceed 60 mo.*

Owner / Applicant Signature: Keith Parsons Date: 12-11-15 Installed by: Lantz Wastewater

IMPROVEMENT PERMIT by: Justin Hawkins Date: 12-4-15 OPERATION PERMIT by: [signature] Date: 04/27/16

AUTHORIZATION TO CONSTRUCT by: Justin Hawkins Date: 12-4-15 Existing System Inspected by: Date:

Health Dept. Copy - WHITE Applicant (Final Approval) - YELLOW Applicant (Conditional Approval) - PINK