IREDELL COUNTY HEALTH DEPARTMENT

STATESVILLE 704-878-5305 MOORESVILLE 704-664-5281

IMPROVEMENT PERMIT / AUTHORIZATION TO CONSTRUCT / OPERATION PERMIT / EXISTING SYSTEM INSPECTION

PERMIT# 86140 PIN# 4708 28 5820 DATE Nov 15 99

OWNER OR CONTRACTOR Dale Gibson PHONE: Business 828 241 3196 Home

ADDRESS Po Box 411 Catawba NC

LOCATION Midway Rd (D) Harris Bridge ~ 4 mile on Left

SUBDIVISION BLOCK / SECTION LOT LOT AREA 1 AC. Plus SITE CLASS PS DESIGN FLOW 360 L.T.A.R. .3 / .25 Repair

Septic Tank: 1000 Gallons; STB 1012 Date 10-3-99
Pump Tank: Gallons; PT Date
Pump Make: Model Serial No.
Nitrification Field: No Fields 1 Square Feet 1200 Linear Feet 400
No Lines 4@100 Trench Width 36 Max Trench Bottom Depth 48"

☒ New System ☐ Repair System Type: I (II) III IV V VI
System Description: Conv Gravity
Repair System Description: 25% Pump Pressure
Maintenance Agreement Required: ☐ Yes ☒ No
Gravel Depth 12"


☐ House/Mod. Home ☒ Mobile Home ☐ Business ☐ Other
No. Bedrooms 3 No. Bathrooms 2 No. Employees
☐ Slab ☒ Crawl Space ☐ Basement w/plumbing ☐ Basement wo/plumbing

Water Supply: ☐ Individual ☒ Public ☐ Community


Comments/Conditions: Call 928-2050 for Final

Comments/Conditions.

INITIAL SITE SKETCH

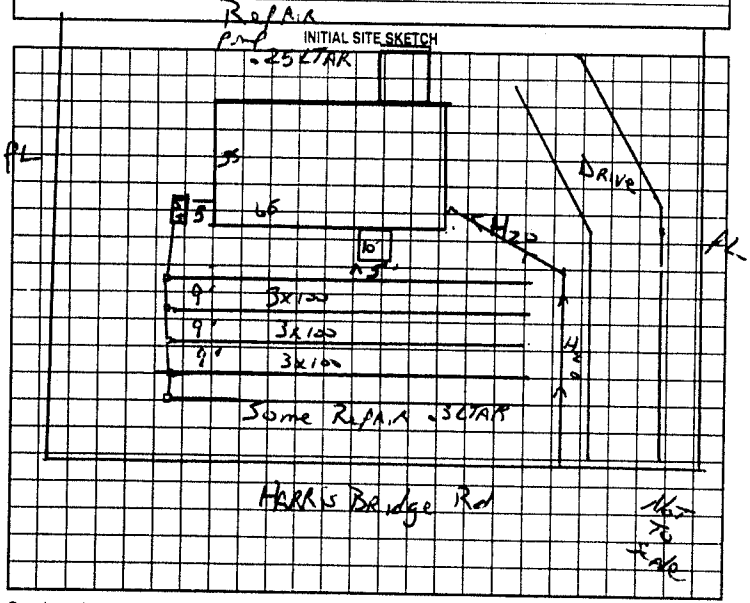

AS BUILT SKETCH

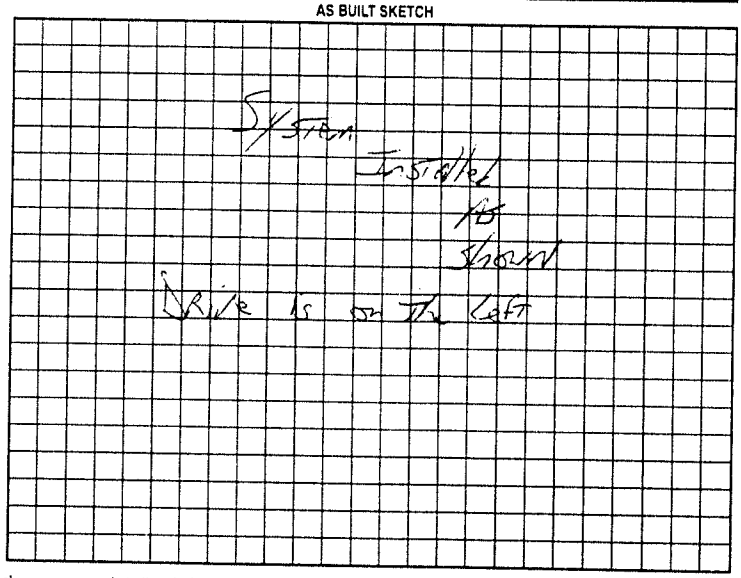

Permit can be suspended or revoked if any false information is supplied toward securing the permit/any unauthorized changes are made to the site/any unauthorized changes are made in the installation of the system. Improvement Permit with plat valid without expiration. Improvement Permit with site plan valid for sixty months. Authorization to Construct is valid for a period equal to that of Improvement Permit – not to exceed sixty months.

Signed: Dale K Gibson date 11/15/99

Improvement Permit by: C Potter date Nov 15 99

Authorization to Construct by: C Potter date Nov 15 99

Installed by: Al Barkley

Operation Permit by: C Potter date Jan 7 2000

Existing System Inspection by: date

HEALTH DEPT. COPY. WHITE OWNER COPY (FINAL) YELLOW OWNER COPY (INITIAL) PINK