IREDELL COUNTY HEALTH DEPARTMENT

Statesville Office (704) 878-5305 Mooresville Office (704) 660-3625 PERMIT # 213361

IMPROVEMENT PERMIT / AUTHORIZATION TO CONSTRUCT / OPERATION PERMIT / EXISTING SYSTEM

PIN # 4708290367

APPLICANT: Rose Presnell APPLICANT ADDRESS: 2201 Buck Shoals Rd Hamptonville NC 27020

SITE ADDRESS: 501 Harris Bridge Rd Stony Point NC 28678 PHONE: 336-473-4703 ALT. PHONE: N/A

SITE DIRECTIONS: 64/90 T/R Midway Rd T/L Harris Bridge Rd Lot on left


SUBDIVISION: Michael Sigsbay Jr SECTION: N/A LOT # TR2 LOT AREA: 0.954 ac DESIGN FLOW: 360 L.T.A.R.: 0.3

Septic Tank	1000 (gal)	STB	160	Date	7-10-15	[X] New System	[ ] Repair	[ ] Expansion	System Type: I II [III] IV V VI	[X] Residence	No. Bedrooms 3
Pump Tank	N/A (gal)	PT	N/A	Date	N/A	System Description:	25% Reduction			[ ] Business	No. Persons 6
Pump Make	N/A	Model	Polylok	Serial #	PL-68	Repair System Description:	25% Reduction			[ ] Other	No. Employees
# Nitrification Fields	1	# Lines	3	Linear Ft:	300	Maintenance Agreement Required:	[ ] YES	[X] NO		[ ] Slab	[X] Crawl Space
Trench Width	36"	Max. Trench Bottom Depth	36"	Gravel Depth	N/A		[X] GRAVITY	[ ] PRESSURE		[ ] Basement w/plumbing	[ ] Basement w/o plumbing


Water Supply: [ ] Private [X] Public [ ] Community

Comments / Conditions: Install 25% reduction on center with Serial distribution. Pump, crush + fill existing tank.

INITIAL SITE SKETCH

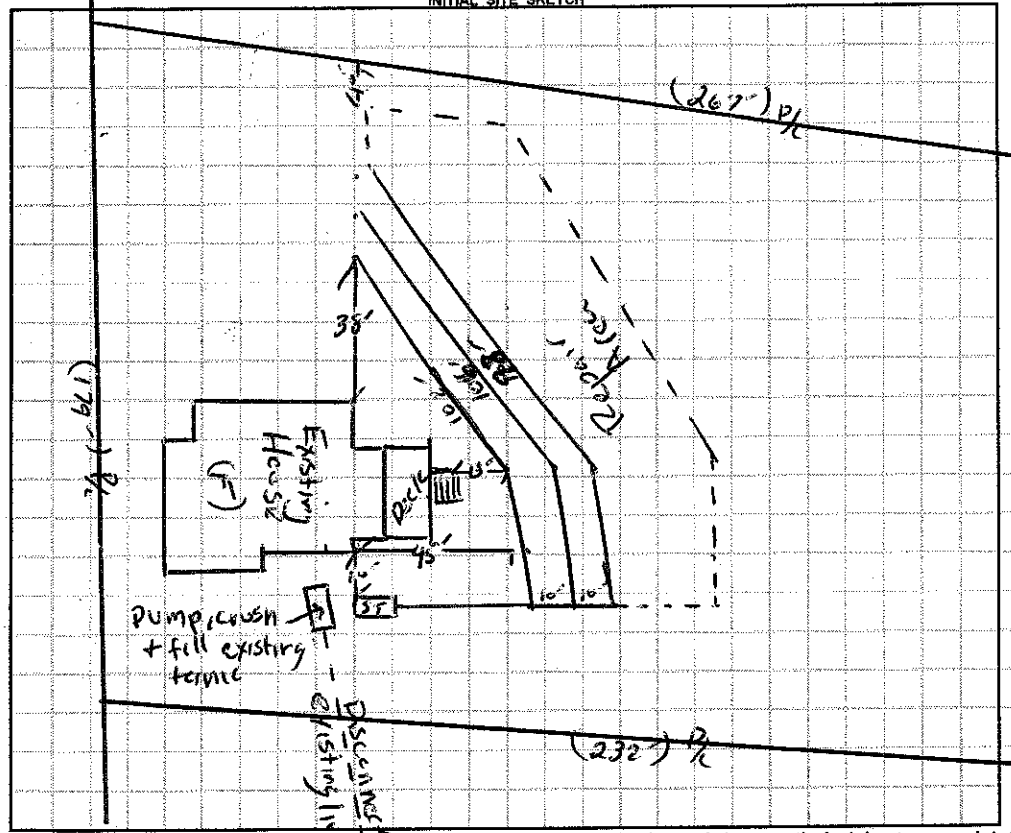

AS BUILT SKETCH

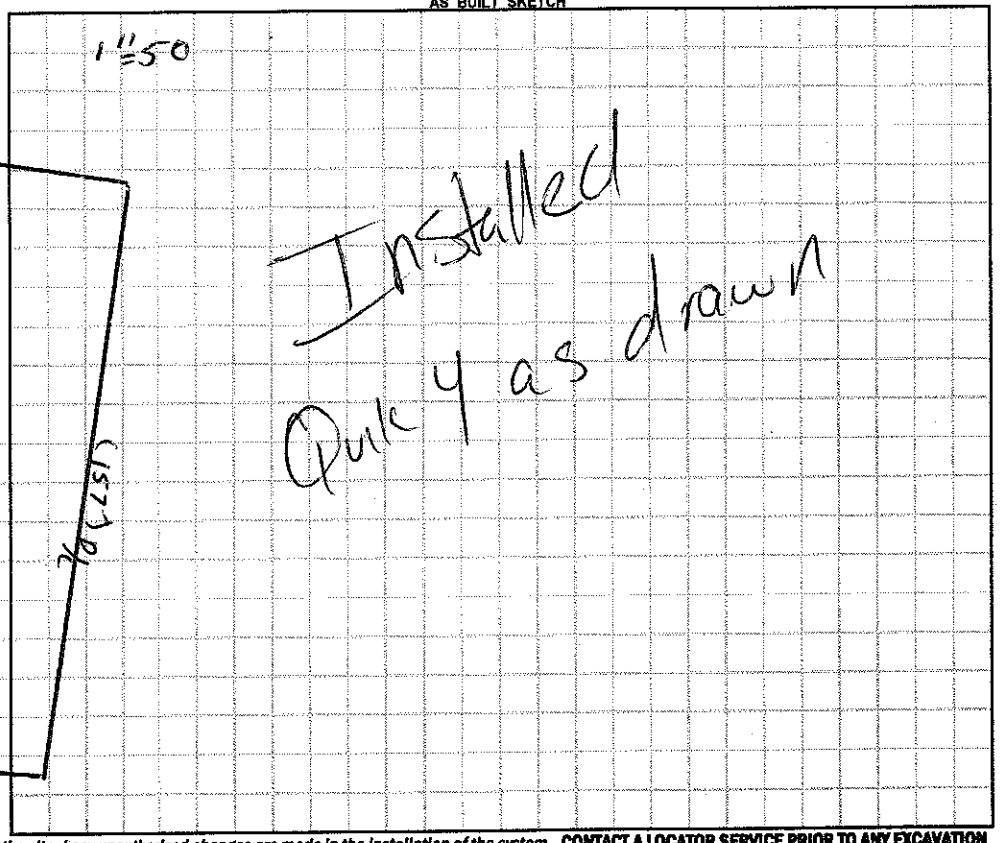

Permit can be suspended or revoked if any false information is supplied toward securing the permit / any unauthorized changes are made to the site / any unauthorized changes are made in the installation of the system. **CONTACT A LOCATOR SERVICE PRIOR TO ANY EXCAVATION**

[ ] **IMPROVEMENT PERMIT** *with plat valid without expiration.* [X] **IMPROVEMENT PERMIT** *with site plan valid for 60 mos.* [X] **AUTHORIZATION TO CONSTRUCT** *valid for period equal to IMPROVEMENT PERMIT--not to exceed 60 mo.*

Owner / Applicant Signature: Rose Presnell Date: 9/9/15 Installed by: K M Grading

IMPROVEMENT PERMIT by: David Adkins Date: 09/09/15 OPERATION PERMIT by: David Adkins Date: 09/09/15

AUTHORIZATION TO CONSTRUCT by: David Adkins Date: 09/09/15 Existing System Inspected by: Date:

Health Dept. Copy - WHITE Applicant (Final Approval) - YELLOW Applicant (Conditional Approval) - PINK