IREDELL COUNTY HEALTH DEPARTMENT

STATESVILLE 704-878-5305 MOORESVILLE 704-664-5281

IMPROVEMENT PERMIT / AUTHORIZATION TO CONSTRUCT / OPERATION PERMIT / EXISTING SYSTEM INSPECTION

PERMIT# REPAIR PIN# DATE 12-14-01

OWNER OR CONTRACTOR DALE MILLSAPS PHONE: Business (704) 878-8600 Home (704) 876-0830

ADDRESS 810 HARRIS BRIDGE ROAD, STONY POINT, NC 28678

LOCATION NC 115 N, TL PISGAH ROAD, TL HARRIS BRIDGE ROAD, 1.0 MILE ON LEFT AT BOX # 810

SUBDIVISION BLOCK / SECTION LOT LOT AREA ACREAGE SITE CLASS PS DESIGN FLOW 360 L.T.A.R. EXISTING

Septic Tank: EXISTING Gallons; STB Date

Pump Tank: Gallons; PT Date

Pump Make: Model Serial No.

Nitrification Field: No Fields 1 Square Feet 600 Linear Feet 200

No Lines TWO Trench Width 36" Max Trench Bottom Depth 36+/- Gravel Depth 12"

☐ New System ☑ Repair System Type: I (II) III. IV. V. VI

System Description: CONVENTIONAL GRAVITY

Repair System Description: CONVENTIONAL GRAVITY

Maintenance Agreement Required: ☐ Yes ☑ No

☑ House/Mod. Home No. Bedrooms 3

☐ Mobile Home No. Bathrooms 1

☐ Business No. Employees

☐ Other


☐ Slab ☑ Crawl Space ☐ Basement w/plumbing ☐ Basement wo/plumbing

Water Supply: ☐ Individual ☑ Public ☐ Community

Comments/Conditions: ① INSTALL NEW DISTRIBUTION BOX AS SHALLOW AS POSSIBLE FEEDING TWO NEW 3'x100' LINES AS SHOWN ② THIS PERMIT SERVES AS "NOTICE of VIOLATION" SYSTEM TO BE REPAIRED BY JANUARY 14, 2001

Comments/Conditions:

INITIAL SITE SKETCH

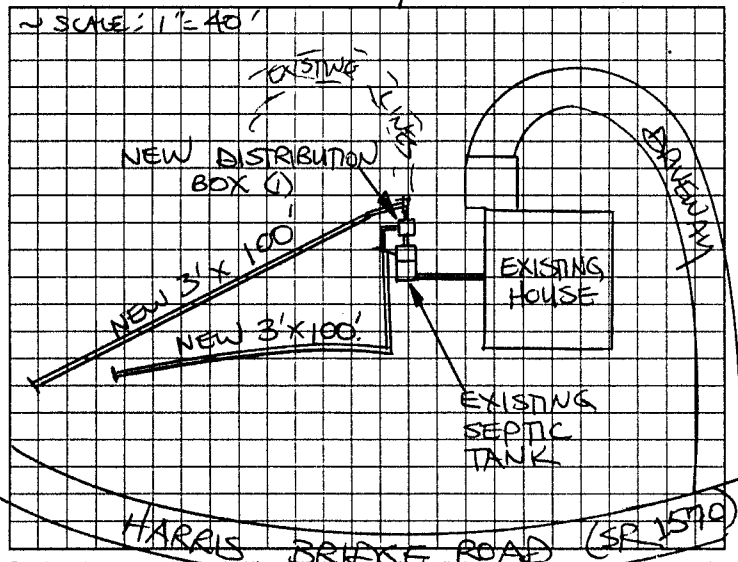

AS BUILT SKETCH

SYSTEM REPAIRED ACCORDING TO INITIAL SITE SKETCH

Permit can be suspended or revoked if any false information is supplied toward securing the permit/any unauthorized changes are made to the site/any unauthorized changes are made in the installation of the system. Improvement Permit with plat valid without expiration. Improvement Permit with site plan valid for sixty months. Authorization to Construct is valid for a period equal to that of Improvement Permit – not to exceed sixty months.

Signed: Dale Millsaps date 12-14-01 Installed by: SAMMY SIDEWAKER / STATESVILLE BACKHOE

Improvement Permit by: STEVE HEDRICK date 12-14-01 Operation Permit by: STEVE HEDRICK date 2-6-02

Authorization to Construct by: STEVE HEDRICK date 12-14-01 Existing System Inspection by: date

HEALTH DEPT. COPY: WHITE OWNER COPY (FINAL): YELLOW OWNER COPY (INITIAL): PINK