IREDELL COUNTY HEALTH DEPARTMENT

STATESVILLE 704-878-5305 MOORESVILLE 704-664-5281

IMPROVEMENT PERMIT / AUTHORIZATION TO CONSTRUCT / OPERATION PERMIT / EXISTING SYSTEM INSPECTION

PERMIT# 90031 PIN# 4708 29 2185 DATE 6-23-00

OWNER OR CONTRACTOR Clayton Homes Tommy Dillon PHONE: Business 873-2547 Home

ADDRESS 2026 Northside Dr.

LOCATION 115N To midway Rd TR Harris Bridge Past Yatkin River 1/2 mile left

SUBDIVISION BLOCK / SECTION LOT LOT AREA .175acres SITE CLASS R5 DESIGN FLOW 360 L.T.A.R. 13

Septic Tank: 1000 Gallons; STB 1012 Date 4-28-00
Pump Tank: Gallons; PT Date
Pump Make: Model Serial No.
Nitrification Field: No Fields 1 Square Feet 1200 Linear Feet 400
No Lines 3 Trench Width 36" Max Trench Bottom Depth 36" Gravel Depth 12"

☐ New System ☐ Repair System Type: ☐ I ☒ II ☐ III, IV, V, VI
System Description: Conv. Gravity
Repair System Description: Gravity 25% Red.
Maintenance Agreement Required: ☐ Yes ☐ No

☐ House/Mod Home ☒ Mobile Home ☐ Business ☐ Other
No. Bedrooms 3 No. Bathrooms 2 No. Employees


☐ Slab ☐ Crawl Space ☐ Basement w/plumbing ☐ Basement wo/plumbing

Water Supply: ☐ Individual ☒ Public ☐ Community


Comments:/Conditions:

Comments:/Conditions:

INITIAL SITE SKETCH

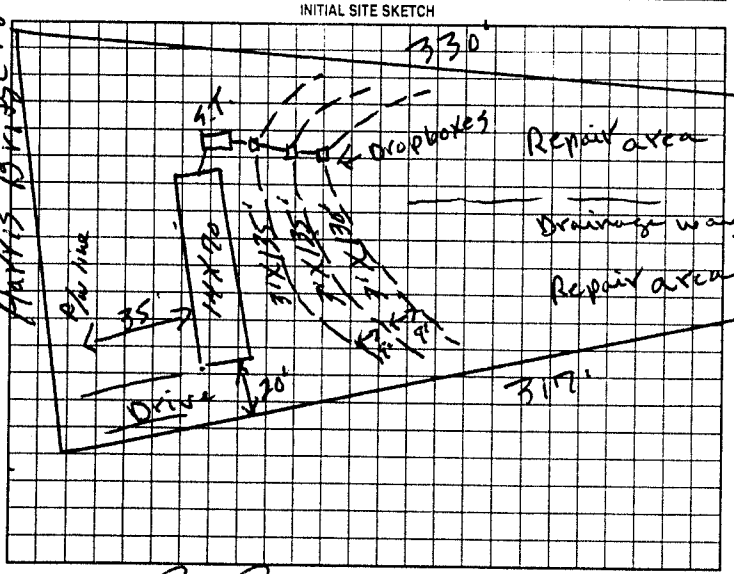

AS BUILT SKETCH

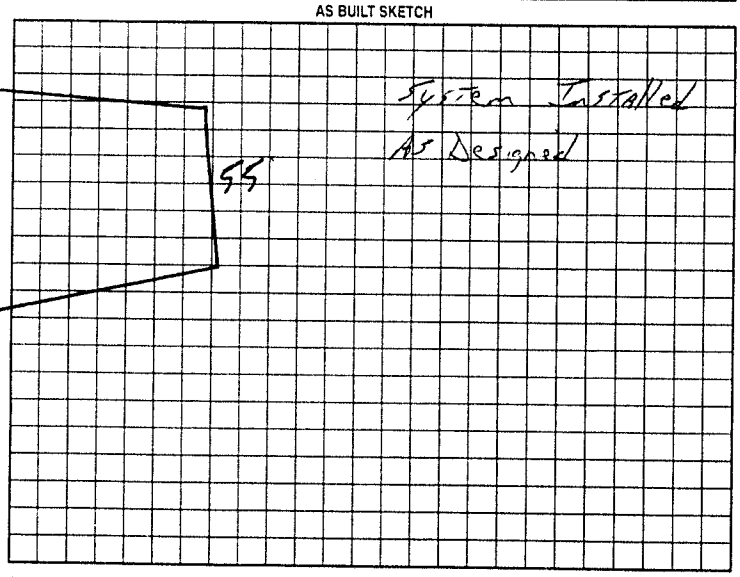

Permit can be suspended or revoked if any false information is supplied toward securing the permit/any unauthorized changes are made to the site/any unauthorized changes are made in the installation of the system. Improvement Permit with plat valid without expiration. Improvement Permit with site plan valid for sixty months. Authorization to Construct is valid for a period equal to that of Improvement Permit – not to exceed sixty months.

Signed: date 6-23-00 Installed by: Al Barkley

Improvement Permit by: P.C. Moore date 6-23-00 Operation Permit by: Joe Potter date June 29-2000

Authorization to Construct by: P.C. Moore date 6-23-00 Existing System Inspection by: date

HEALTH DEPT. COPY WHITE OWNER COPY (FINAL) YELLOW OWNER COPY (INITIAL) PINK