1130

IREDELL COUNTY HEALTH DEPARTMENT - *ENVIRONMENTAL HEALTH* ☑ STATESVILLE OFFICE 704-878-5305 ☐ MOORESVILLE OFFICE 704-664-5281

IMPROVEMENT PERMIT / AUTHORIZATION TO CONSTRUCT / OPERATION PERMIT / EXISTING SYSTEM INSPECTION

PERMIT # REPAIR PIN # 4708-29-6143 DATE APRIL 2, 2012

OWNER BAXTER L. MILLSAPS, III APPLICANT: SAME PHONE: Home/Cell # 646-709-1794 Business #

SITE ADDRESS 774 HARRIS BRIDGE ROAD OWNER / APPLICANT ADDRESS SAME

SITE DIRECTIONS MIDWAY ROAD TO HARRIS BRIDGE ROAD, 3.6 MILES ON RIGHT AT BOX #774

SUBDIVISION BLOCK / SECTION LOT # LOT AREA 0.52 ACRE DESIGN FLOW 360 L.T.A.R. 0.30 GPD/FT2

Septic Tank EXISTING Gallons: STB Date

Pump Tank Gallons: P T Date

Pump Make Model Serial #

No. Nitrification Fields: 1 No. Lines 4 Linear Feet 300

Trench Width 36" Max. Trench Bottom Depth 33" Gravel Depth N/A

☐ New System ☑ Repair ☐ Expansion System Type I II (III) IV V VI

System Description:

Repair System Description: 25% REDUCTION SYSTEM

Maintenance Agreement Required ☐ YES ☑ NO

☑ GRAVITY ☐ PRESSURE

☑ Residence No. Bedrooms 3

☐ Business No. Persons

☐ Other No. Employees

☐ Slab ☑ Crawl Space

☐ Basement w/plumbing ☐ Basement w/o plumbing


Water Supply: ☑ Private (WELL) ☐ Public ☐ Community

Comments / Conditions ① REPAIR LEAKY TOILET FIXTURE

② INSTALL NEW 25% REDUCTION SYSTEM ON CONTOUR AS SHOWN, USING SERIAL DISTRIBUTION

③ ABANDON DAMAGED EXISTING DRAINFIELD

INITIAL SITE SKETCH

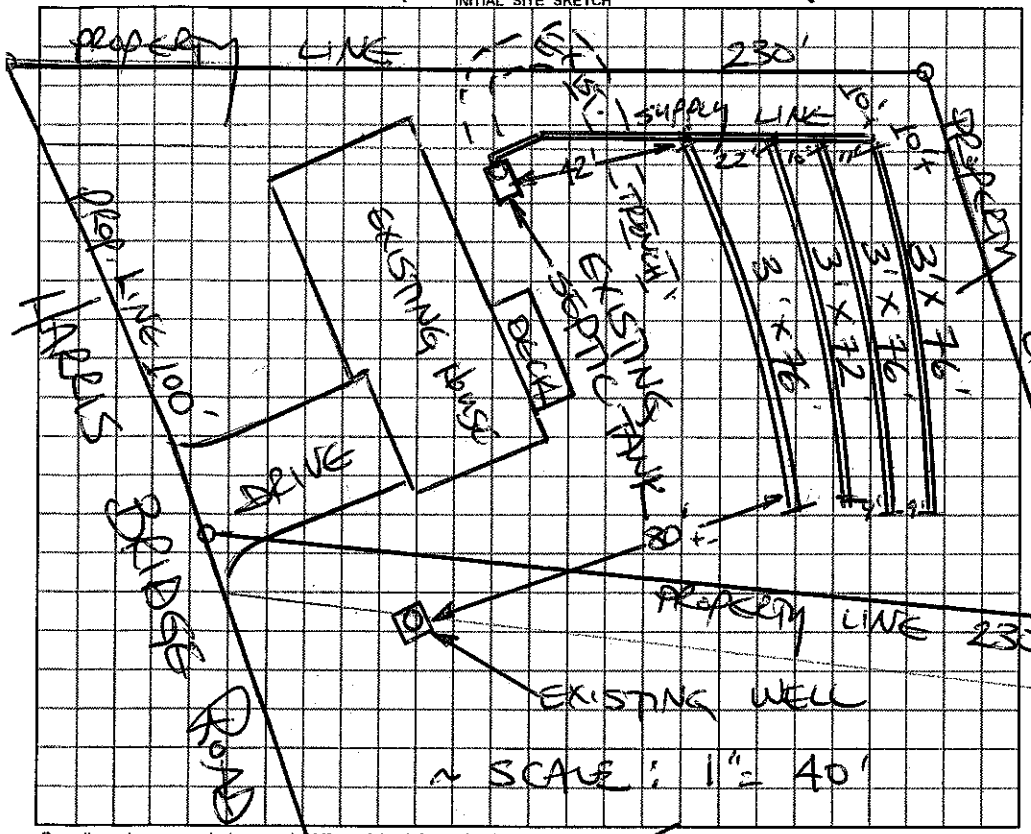

AS BUILT SKETCH

Leak not fixed at time of inspection

Permit can be suspended or revoked if any false information is supplied toward securing the permit / any unauthorized changes are made to the site / any unauthorized changes are made in the installation of the system.

☐ ***IMPROVEMENT PERMIT*** *with plat valid without expiration.* ☑ ***IMPROVEMENT PERMIT*** *with plat valid without expiration, site plan valid 60 mo.* ☑ ***AUTHORIZATION TO CONSTRUCT*** valid for period equal to IMPROVEMENT PERMIT--not to exceed 60 mo.

Owner / Applicant Signature: Mrs. Rosalind S. Millsaps Date Apr. 2, 2012 Installed by: A-1 Backhoe

IMPROVEMENT PERMIT by: STEVE HEDRICK REHS Date 4-2-2012 OPERATION PERMIT by: REHS Date 4-12-12

AUTHORIZATION TO CONSTRUCT by: STEVE HEDRICK REHS Date 4-2-2012 Existing System Inspected by: REHS Date

YOU SHOULD CONTACT A LOCATOR SERVICE PRIOR TO ANY EXCAVATION

White Copy – Environmental Health YELLOW COPY (Final) Owner / Applicant PINK COPY (Initial) Owner / Applicant