IREDELL COUNTY HEALTH DEPARTMENT

STATESVILLE 704-878-5305 MOORESVILLE 704-664-5281

IMPROVEMENT PERMIT / CERTIFICATE OF COMPLETION / OPERATION PERMIT / EXISTING SYSTEM INSPECTION

PROPERTY DESCRIPTION NO. 069151 DATE 9-4-97

OWNER OR CONTRACTOR Joseph Harris TAX MAP NO. 4708465342 Watershed: ☐ Yes ☐ No

ADDRESS 108 Bridgemeadow Loop Stony Point PHONE: Business Home WSWPA

LOCATION 115N TL Midway Rd TR Harris Bridge TR Ridgemeadow

SUBDIVISION BLOCK / SECTION LOT LOT AREA SITE CLASS. DESIGN FLOW 240 L.T.A.R.

Septic Tank: 1000 Gallons; STB Date

Pump Tank: Gallons; PT Date

Pump Make: Model Serial No.

Nitrification Field: No Fields Square Feet Linear Feet

No Lines Trench Width Max Trench Bottom Depth Gravel Depth

☐ New System ☐ Repair System Type: I, II, III, IV, V, VI

System Description:

Repair System Description:

Maintenance Agreement Required: ☐ Yes ☐ No

☒ House/Mod. Home No. Bedrooms 3

☐ Mobile Home No. Bathrooms 2

☐ Business No. Employees

☐ Other

☐ Slab ☒ Crawl Space ☐ Basement w/plumbing ☐ Basement wo/plumbing


Water Supply: ☒ Individual ☐ Community ☐ Public

Comments:

Comments: Existing System Check

INITIAL SITE SKETCH

AS BUILT SKETCH

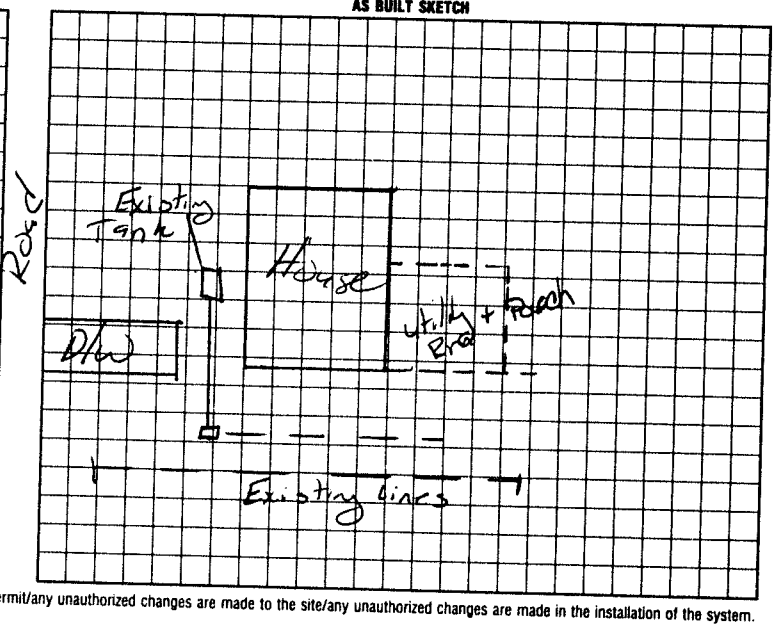

I understand that this permit can be suspended or revoked if any false information is supplied toward securing the permit/any unauthorized changes are made to the site/any unauthorized changes are made in the installation of the system. Improvement Permit is valid for 60 months from date of issuance.

Signed: Joe Harris

Improvement Permit by: date

Existing System Inspection by: Mary C Ortiz RS date 9-4-97

Installed by:

Certificate of Completion by: date

Operation Permit by: date

HEALTH DEPT. COPY: WHITE INSPECTION COPY (FINAL): GREEN OWNER COPY (FINAL): YELLOW INSPECTION COPY (INITIAL): PINK OWNER COPY (INITIAL): GOLD