45876

IREDELL COUNTY HEALTH DEPARTMENT

STATESVILLE 704-878-5305 MOORESVILLE 704-664-5281

IMPROVEMENT PERMIT / CERTIFICATE OF COMPLETION / OPERATION PERMIT / EXISTING SYSTEM INSPECTION

PROPERTY DESCRIPTION NO. 15596 DATE 6/23/93 TAX MAP NO. 14D-A-48

OWNER OR CONTRACTOR SCOTT LUNSFORD PHONE: Business 878-4217 Home

ADDRESS

LOCATION NC 90W, TR MIDWAY ROAD, TL HARRIS BRIDGE ROAD, 1ST DRIVE ON (R) PAST BRIDGE

SUBDIVISION BLOCK / SECTION LOT LOT AREA SITE CLASS L.T.A.R.

Water Supply: ☑ Individual ☐ Community ☐ Public

Septic Tank: 1000 Gallons: STB 358 Date 8-14-93

Pump Tank: — Gallons: PT — Date —

Nitrification Field: No. Fields 1 Square Feet 1200 Linear Feet 400

No. Lines 4 Trench Width 36" Trench Depth 36" Gravel Depth 12"

☑ New System ☐ Repair System Type: I. II. III. IV. V. VI

System Description: CONV. GRAVITY

Repair System Description: CONV. GRAVITY

Maintenance Agreement Required: ☐ Yes ☑ No

☑ House/Mod. Home ☐ Mobile Home ☐ Business ☐ Other

No. Bedrooms 3 No. Bathrooms 3 No. Employees

Garbage Disposal: ☐ Yes ☑ No

Auto. Dishwasher: ☐ Yes ☐ No

Auto. Washing Machine: ☐ Yes ☐ No


Other

☐ Slab ☐ Crawl Space ☑ Basement w/plumbing ☐ Basement wo/plumbing

Comments 100% Repair Area Across drive, conventional, gravity fed.

INITIAL SITE SKETCH

AS BUILT SKETCH

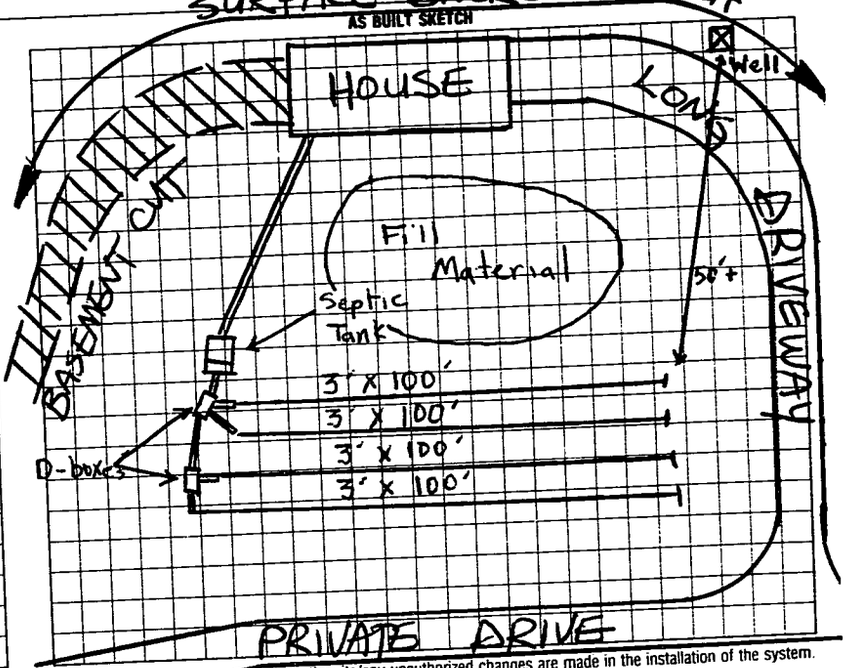

I understand that this permit can be suspended or revoked if any false information is supplied toward securing the permit/any unauthorized changes are made to the site/any unauthorized changes are made in the installation of the system. Improvement Permit is valid for 60 months from date of issuance.

Signed:

Improvement Permit by: STEVE HEDRICK date 12/18/92

Existing System Inspection by: date

Installed by: A-1 BACKHOE 100% Repair Area date 8-23-93

Certificate of Completion by: Michael J. Dennis date

Operation Permit by: date

HEALTH DEPT. COPY: WHITE INSPECTION COPY (FINAL): GREEN OWNER COPY (FINAL): YELLOW INSPECTION COPY (INITIAL): PINK OWNER COPY (INITIAL): GOLD