IREDELL COUNTY HEALTH DEPARTMENT

STATESVILLE 704-878-5305 MOORESVILLE 704-664-5281

IMPROVEMENT PERMIT / AUTHORIZATION TO CONSTRUCT / OPERATION PERMIT / EXISTING SYSTEM INSPECTION

PERMIT# 081150 PIN# 4708 37 3561 DATE 6-15-99

OWNER OR CONTRACTOR TIMOTHY JOHNSON PHONE: Business Home 876-3992

ADDRESS 167 SOJOURNER LANE, STONY POINT, NC 28678

LOCATION NC 115 N, TL MIDWAY RD, TR HARRIS BRIDGE, 1ST LOT ON RIGHT PAST SOJOURNER LANE

SUBDIVISION BLOCK / SECTION LOT LOT AREA 2.43 (PT) SITE CLASS PS DESIGN FLOW 360 L.T.A.R. 0.30 GPD/FT²

Septic Tank: 1000 Gallons; STB 1012 Date 5-29-00
Pump Tank: Gallons; PT Date
Pump Make: Model Serial No.
Nitrification Field: No Fields 1 Square Feet 1200 Linear Feet 200
No Lines FOUR Trench Width 24" Max Trench Bottom Depth 36" Gravel Depth SAND 6"

☑ New System ☐ Repair System Type: I, II, (III), IV, V, VI
System Description: PPBPS GRAVITY-FED
Repair System Description: PPBPS PUMP/GRAVITY
Maintenance Agreement Required: ☐ Yes ☑ No


☑ House/Mod. Home No. Bedrooms 3
☐ Mobile Home No. Bathrooms 2
☐ Business No. Employees
☐ Other
☐ Slab ☐ Crawl Space ☐ Basement w/plumbing ☐ Basement wo/plumbing

Water Supply: ☐ Individual ☑ Public ☐ Community


Comments/Conditions: ① INSTALL FORM-FOUR (44) PPBPS PANELS IN FOUR EQUAL LENGTH LINES ON CONTOUR ② USE THREE FLOW DIVIDER TEES TO ACHIEVE EQUAL DISTRIBUTION INTO EACH OF FOUR LINES.

Comments/Conditions

INITIAL SITE SKETCH

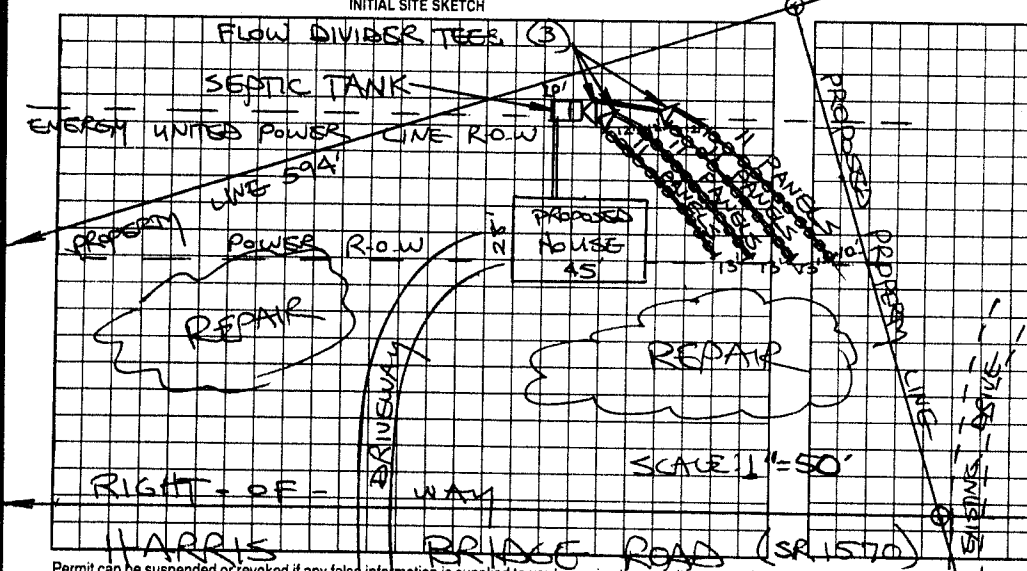

AS BUILT SKETCH

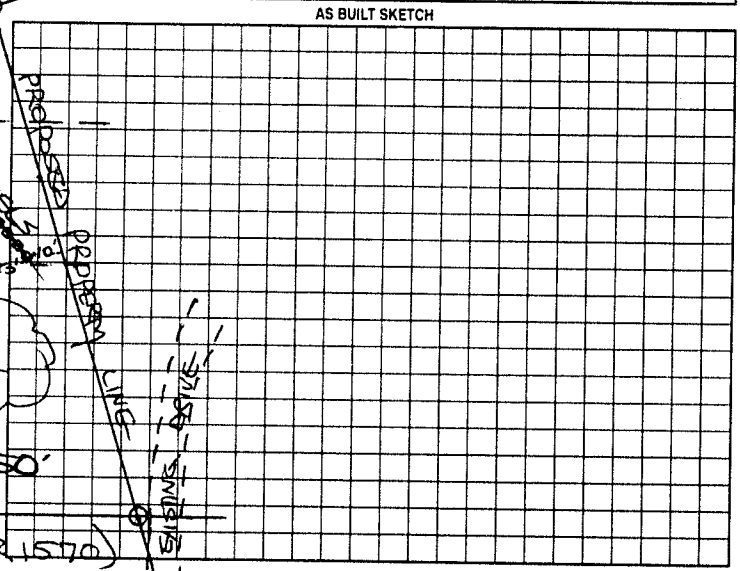

Permit can be suspended or revoked if any false information is supplied toward securing the permit/any unauthorized changes are made to the site/any unauthorized changes are made in the installation of the system. Improvement Permit with plat valid without expiration. Improvement Permit with site plan valid for sixty months. Authorization to Construct is valid for a period equal to that of Improvement Permit – not to exceed sixty months.

Signed: date 6-25-99 Installed by: A-1 Backhoe

Improvement Permit by: STEVE HEDRICK date 6-15-99 Operation Permit by: Mat Coffey date 8-15-00

Authorization to Construct by: STEVE HEDRICK date 6-15-99 Existing System Inspection by: date

HEALTH DEPT. COPY WHITE OWNER COPY (FINAL) YELLOW OWNER COPY (INITIAL) PINK