IREDELL COUNTY HEALTH DEPARTMENT

STATESVILLE 704-878-5305 MOORESVILLE 704-664-5281

IMPROVEMENT PERMIT / AUTHORIZATION TO CONSTRUCT / OPERATION PERMIT / EXISTING SYSTEM INSPECTION

PERMIT# 083032 PIN# 4708 38 2541 DATE 8-12-99

OWNER OR CONTRACTOR PATRICIA THOMAS PHONE: Business Home 873-8735

ADDRESS 320 EAST END AVE, STATESVILLE, NC 28677

LOCATION NC 115 N, TL MIDWAY RD, TR HARRIS BRIDGE ROAD, 0.5 MILE ON RIGHT PAST BRIDGE

SUBDIVISION BLOCK / SECTION LOT LOT AREA 7.21 ACRE SITE CLASS PS DESIGN FLOW 360 L.T.A.R. 0.30 GPD/FT²

Septic Tank: 1000 Gallons; STB 825 Date 11-1-99
Pump Tank: Gallons; PT Date
Pump Make: Model Serial No.
Nitrification Field: No Fields 1 Square Feet @ p 1200 Linear Feet 300'
No Lines FOUR Trench Width 36" Max Trench Bottom Depth 36" Gravel Depth SAND 6"

☑ New System ☐ Repair System Type: I, II, III, IV, V, VI
System Description: 25% REDUCTION GRAVITY
Repair System Description: 25% REDUCTION PUMP
Maintenance Agreement Required: ☐ Yes ☑ No
☐ Slab ☑ Crawl Space ☐ Basement w/plumbing ☐ Basement wo/plumbing


☐ House/Mod. Home No. Bedrooms 3
☐ Mobile Home No. Bathrooms 2
☐ Business No. Employees
☐ Other FUTURE 3 BR HOUSE

Water Supply: ☐ Individual ☑ Public ☐ Community

Comments/Conditions: ① INSTALL 25% REDUCTION SYSTEM USING FIFTY (50) CHAMBERS OR THIRTY (30) HDS SECTIONS ON CONTOUR AS FLAGGED ON SITE.

Comments/Conditions ② MH TO BE REMOVED UPON OCCUPANCY OF FUTURE HOUSE.

INITIAL SITE SKETCH

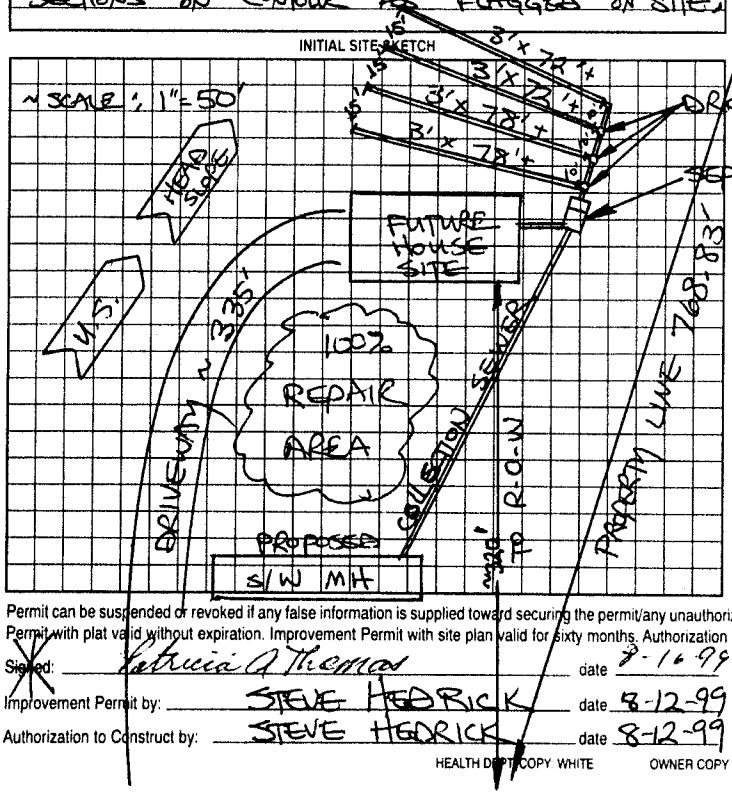

AS BUILT SKETCH

DROP BOXES (3)

SEPTIC TANK

SEPTIC TANK WITH RISERS INSTALLED USING "POLYLOK" FILTER

SYSTEM INSTALLED ~~WRONG~~ ACCORDING TO INITIAL SITE SKETCH

Permit can be suspended or revoked if any false information is supplied toward securing the permit/any unauthorized changes are made to the site/any unauthorized changes are made in the installation of the system. Improvement Permit with plat valid without expiration. Improvement Permit with site plan valid for sixty months. Authorization to Construct is valid for a period equal to that of Improvement Permit – not to exceed sixty months.

Signed: Patricia A Thomas date 8-16-99

Improvement Permit by: STEVE HEDRICK date 8-12-99

Authorization to Construct by: STEVE HEDRICK date 8-12-99

Installed by: ROWAN SEPTIC TANK

Operation Permit by: STEVE HEDRICK date 12-28-99

Existing System Inspection by: date

HEALTH DEPT COPY WHITE OWNER COPY (FINAL) YELLOW OWNER COPY (INITIAL) PINK