60768

IREDELL COUNTY HEALTH DEPARTMENT

STATESVILLE 704-878-5305 MOORESVILLE 704-664-5281

IMPROVEMENT PERMIT / CERTIFICATE OF COMPLETION / OPERATION PERMIT / EXISTING SYSTEM INSPECTION

PROPERTY DESCRIPTION NO. 23777 DATE 5-3-96 TAX MAP NO. PART OF 9R-A7 Watershed: ☐ Yes ☒ No

OWNER OR CONTRACTOR GE VANG (XIONG VANG) PHONE: Business Home 585-6145

ADDRESS 160 DEEP WOODS DRIVE, STANLEY, NC 28078

LOCATION NC 90 W, TR MIDWAY RD, TR HARRIS BRIDGERS, TR WILDERNESS LANE, TR DEEP WOODS LN,

SUBDIVISION POO-KOOM BLOCK / SECTION LOT 1 LOT AREA AMPLE SITE CLASS P3 DESIGN FLOW 480 L.T.A.R. 0.30 GPD/FT²

Septic Tank: 1000 Gallons; STB 3260 Date 5/22/96

Pump Tank: Gallons; PT Date

Pump Make: Model Serial No.

Nitrification Field: No Fields 1 Square Feet 1600 Linear Feet 533

No Lines 4 Trench Width 36" Max Trench Bottom Depth 18-36" Gravel Depth 12"

☒ New System ☐ Repair System Type: I, II, III, IV, V, VI

System Description: CONVENTIONAL, GRAVITY

Repair System Description: CONV. GRAVITY

Maintenance Agreement Required: ☐ Yes ☒ No

☐ House/Mod. Home ☒ Mobile Home ☐ Business ☐ Other

No. Bedrooms 4 No. Bathrooms 2 No. Employees


☐ Slab ☒ Crawl Space ☐ Basement w/plumbing ☐ Basement wo/plumbing

Water Supply: ☒ Individual ☒ Community ☐ Public WELL

Comments: KEEP WELL MINIMUM 100' FROM SEPTIC SYSTEM

Comments:

INITIAL SITE SKETCH

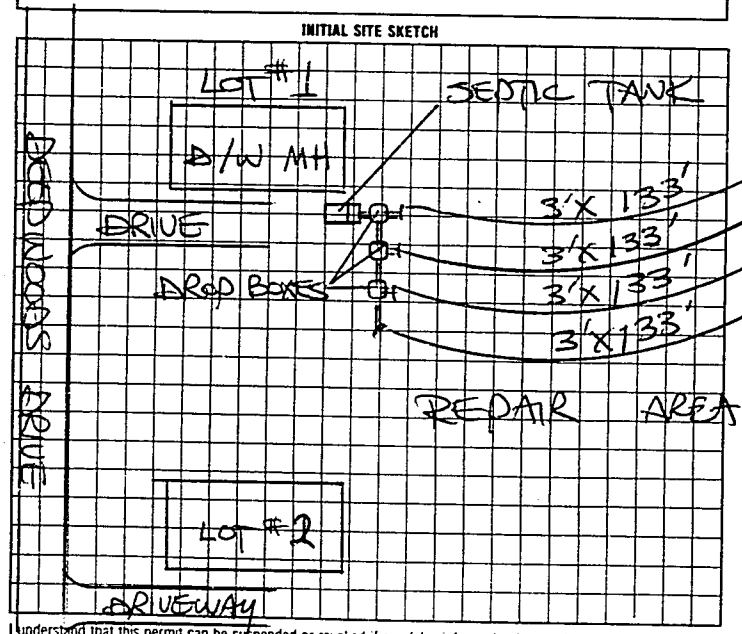

AS BUILT SKETCH

SYSTEM INSTALLED ACCORDING TO INITIAL SITE SKETCH

1ST MH SITE ON LEFT.

I understand that this permit can be suspended or revoked if any false information is supplied toward securing the permit/any unauthorized changes are made to the site/any unauthorized changes are made in the installation of the system.

Authorization to Construct is valid five (5) years from date of issuance. Improvement Permit has no expiration date.

Signed: X Y Vang

Improvement Permit by: STEVE HEDRICK date 5-3-96

Existing System Inspection by: STEVE HEDRICK date 5-3-96

AUTHORIZATION TO CONSTRUCT:

Installed by: G & M ENTERPRISES

Certificate of Completion by: date

Operation Permit by: STEVE HEDRICK date 6-24-96

HEALTH DEPT COPY WHITE INSPECTION COPY (FINAL) GREEN OWNER COPY (FINAL) YELLOW INSPECTION COPY (INITIAL) PINK OWNER COPY (INITIAL)