60766

IREDELL COUNTY HEALTH DEPARTMENT

STATESVILLE 704-878-5305 MOORESVILLE 704-664-5281

IMPROVEMENT PERMIT / CERTIFICATE OF COMPLETION / OPERATION PERMIT / EXISTING SYSTEM INSPECTION

PROPERTY DESCRIPTION NO. 23778 DATE 5-3-96 TAX MAP NO. PART of 9R-A-7 Watershed: ☐ Yes ☒ No

OWNER OR CONTRACTOR SE VANG (CHAY VANG) PHONE: Business ____ Home 585-6145

ADDRESS 160 DEEP WOODS DRIVE STONY POINT NC 28678

LOCATION NC 90 W TR MIDWAY RD, TL HARRIS BRACE RD, TR WILDERNESS LANE, TR DEEP WOODS DR, 2ND LOT ON LEFT

SUBDIVISION POC-KOON VILLAGE BLOCK / SECTION ____ LOT 2 LOT AREA AMPLE SITE CLASS. PS DESIGN FLOW 480 L.T.A.R. 0.30 gpd/ft²

Septic Tank: 1000 Gallons; STB 826 Date 5/24/96

Pump Tank: ____ Gallons; PT ____ Date ____

Pump Make: ____ Model ____ Serial No. ____

Nitrification Field: No Fields 1 Square Feet 1600 Linear Feet 533

No Lines 5 Trench Width 36" Max Trench Bottom Depth 18-36

☒ New System ☐ Repair System Type: I, II, III, IV, V, VI

System Description: CONVENTIONAL GRAVITY

Repair System Description: CONV. GRAVITY

Maintenance Agreement Required: ☐ Yes ☒ No

Gravel Depth 12"

☐ House/Mod. Home No. Bedrooms 4

☒ Mobile Home No. Bathrooms 2

☐ Business No. Employees ____

☐ Other ____


☐ Slab ☒ Crawl Space ☐ Basement w/plumbing ☐ Basement wo/plumbing

Water Supply: ☒ Individual ☒ Community ☐ Public

Comments: KEEP SYSTEM MINIMUM 100' FROM WELL

Comments:

INITIAL SITE SKETCH

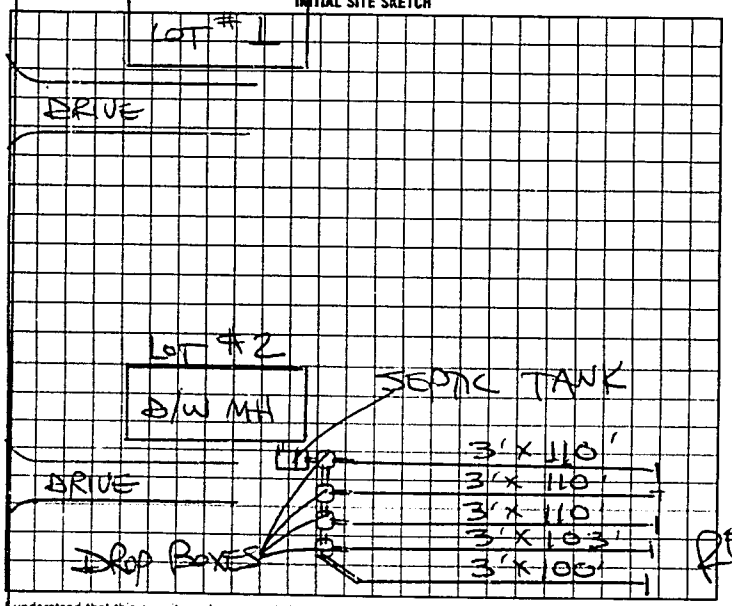

AS BUILT SKETCH

SYSTEM INSTALLED ACCORDING TO INITIAL SITE SKETCH

I understand that this permit can be suspended or revoked if any false information is supplied toward securing the permit/any unauthorized changes are made to the site/any unauthorized changes are made in the installation of the system. Authorization to Construct is valid five (5) years from date of issuance. Improvement Permit has no expiration date.

Signed: ____

Improvement Permit by: STEVE HEDRICK date 5-3-96

Evaluation/Authorization to Construct: STEVE HEDRICK date 5-3-96

Installed by: G & M ENTERPRISES

Certificate of Completion by: ____ date ____

Operation Permit by STEVE HEDRICK date 6-24-96

HEALTH DEPT COPY WHITE | INSPECTION COPY (FINAL) GREEN | OWNER COPY (FINAL) YELLOW | INSPECTION COPY (INITIAL) PINK | OWNER COPY (INITIAL) GOLD

9 5 9 2 0 0