This permit Voids Permit issued 9-8-00

IREDELL COUNTY HEALTH DEPARTMENT

STATESVILLE 704-878-5305 MOORESVILLE 704-664-5281

IMPROVEMENT PERMIT / AUTHORIZATION TO CONSTRUCT / OPERATION PERMIT / EXISTING SYSTEM INSPECTION

PERMIT# 01448 PIN# 4708 63 1351 (PT) DATE

OWNER OR CONTRACTOR Ernest Runge PHONE: Business (704) 872-6645 Home

ADDRESS 374 Long Island Rd Statesville NC 28677

LOCATION NC 90 W, (R) Midway Rd, (L) Harris Bridge Rd (R) Wildcrass Lane at end on left

SUBDIVISION BLOCK / SECTION LOT LOT AREA 16.03 Acres SITE CLASS 5 DESIGN FLOW 480 L.T.A.R. .35 gpd/ft²

Septic Tank: 1000 Gallons: STB 1012 Date

Pump Tank: Gallons: PT Date

Pump Make: Model Serial No.

Nitrification Field: No Fields 1 Square Feet 1372 Linear Feet 460

No Lines 4@115' Trench Width 36" Max Trench Bottom Depth 36" Gravel Depth 12"

☒ New System ☐ Repair System Type: I. II. III. IV. V. VI

System Description: Gravity, Conventional

Repair System Description: Gravity, Conventional

Maintenance Agreement Required: ☐ Yes ☒ No

☐ House/Mod. Home ☒ Mobile Home ☐ Business ☐ Other

No. Bedrooms 3 No. Bathrooms No. Employees

☐ Slab ☒ Crawl Space ☐ Basement w/plumbing ☐ Basement wo/plumbing


Water Supply: ☐ Individual ☐ Public ☐ Community

Comments/Conditions: ① Do not install when wet ② Install liner or contour ③ Keep system 100 ft from well


Comments/Conditions:

- Poly Lok Filter Installed
- Septic Tank marker Installed

INITIAL SITE SKETCH

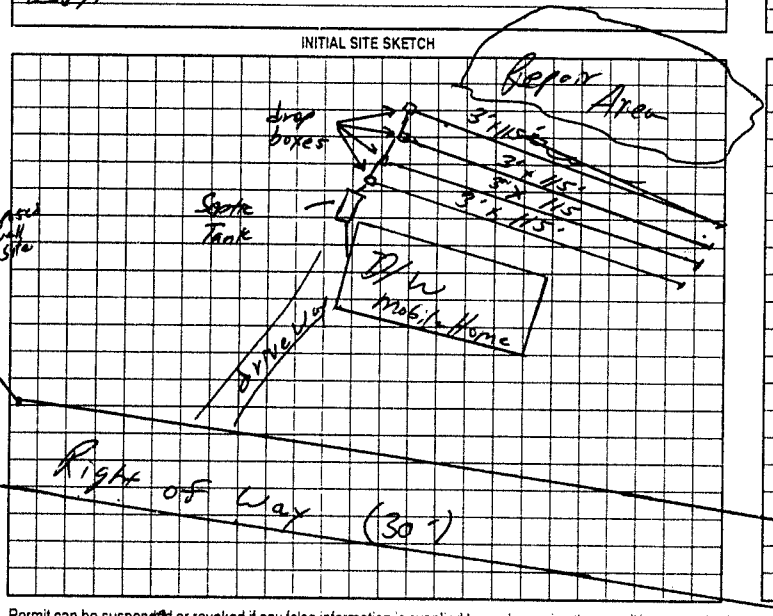

AS BUILT SKETCH

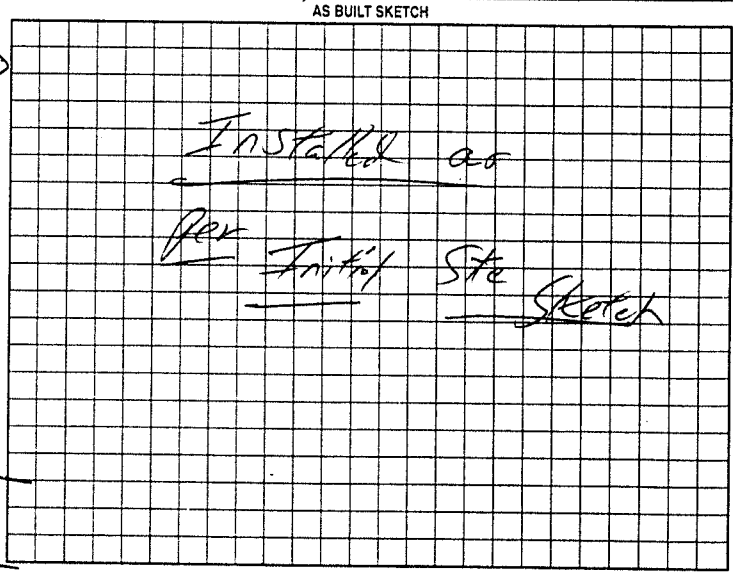

Permit can be suspended or revoked if any false information is supplied toward securing the permit/any unauthorized changes are made to the site/any unauthorized changes are made in the installation of the system. Improvement Permit with plat valid without expiration. Improvement Permit with site plan valid for sixty months. Authorization to Construct is valid for a period equal to that of Improvement Permit – not to exceed sixty months.

Signed: date 8-15-01 Installed by: A-1 Back hoe

Improvement Permit by: William O. Johnson date 7-18-01 Operation Permit by: William O. Johnson date 7/19/01

Authorization to Construct by: William O. Johnson date 7-18-01 Existing System Inspection by: date

HEALTH DEPT. COPY: WHITE OWNER COPY (FINAL): YELLOW OWNER COPY (INITIAL): PINK