IREDELL COUNTY HEALTH DEPARTMENT

Statesville Office (704) 878-5305 Mooresville Office (704) 660-3625 PERMIT # 178323

IMPROVEMENT PERMIT / AUTHORIZATION TO CONSTRUCT / OPERATION PERMIT / EXISTING SYSTEM

PIN # 4708782804

APPLICANT: Clayton Homes (Gordon Smoot) APPLICANT ADDRESS: 2026 Northside Dr.

SITE ADDRESS: 164 Walkers Valley Dr., Stony Point, NC PHONE: 704-239-3693 ALT. PHONE: N/A


SITE DIRECTIONS: Hwy 115 N TL Pisgah Ch. Rd. TL Walker Valley Dr.

SUBDIVISION: N/A SECTION: N/A LOT # N/A LOT AREA: 6.93 acres DESIGN FLOW: 360gpd L.T.A.R.: 0.25

Septic Tank	1000 (gal)	STB	760	Date	6-14-16	☑ New System	☐ Repair	☐ Expansion	System Type: I II (III) IV V VI	☑ Residence	No. Bedrooms	3	Water Supply
Pump Tank	N/A (gal)	PT	N/A	Date	N/A	System Description:	25% Reduction			☐ Business	No. Persons		☑ Private
Pump Make	N/A	Model	Polylok	Serial #	P/-65	Repair System Description:	25% Reduction			☐ Other	No. Employees		☐ Public
# Nitrification Fields	1	# Lines	4	Linear Ft:	360	Maintenance Agreement Required:	☐ YES	☑ NO		☐ Slab	☑ Crawl Space		☐ Community
Trench Width	36"	Max. Trench Bottom Depth	24"	Gravel Depth	N/A		☑ GRAVITY	☐ PRESSURE		☐ Basement w/ plumbing		☐ Basement w/o plumbing	

Comments / Conditions: Install a 25% Reduction System on contour with serial distribution.

INITIAL SITE SKETCH

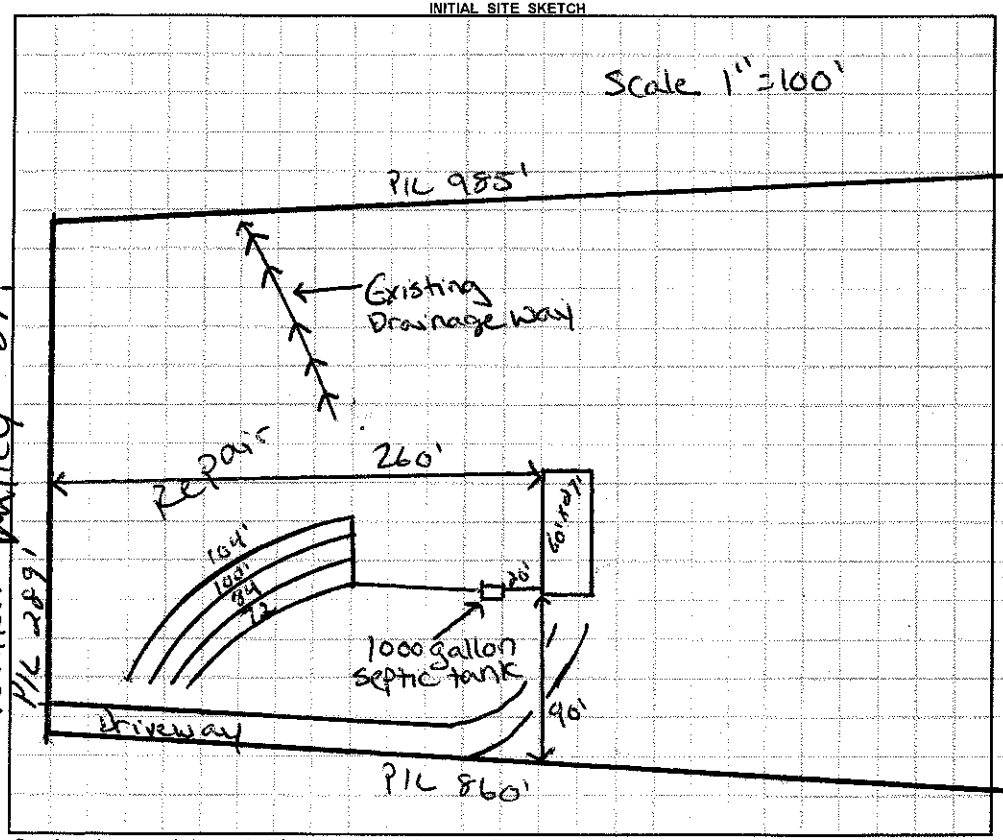

AS BUILT SKETCH

Installed Arc 36 as drawn

Permit can be suspended or revoked if any false information is supplied toward securing the permit / any unauthorized changes are made to the site / any unauthorized changes are made in the installation of the system. **CONTACT A LOCATOR SERVICE PRIOR TO ANY EXCAVATION**

☐ **IMPROVEMENT PERMIT** *with plat valid without expiration.* ☑ **IMPROVEMENT PERMIT** *with site plan valid for 60 mos.* ☑ **AUTHORIZATION TO CONSTRUCT** *valid for period equal to IMPROVEMENT PERMIT--not to exceed 60 mo.*

Owner / Applicant Signature: [signature] Date: 5/14/13 Installed by: Above Grading & Clearing

IMPROVEMENT PERMIT by: Justin Henderson Date: 5-14-13 OPERATION PERMIT by: [signature] Date: 09/25/16

AUTHORIZATION TO CONSTRUCT by: Justin Henderson Date: 5-14-13 Existing System Inspected by: Date:

Health Dept. Copy - WHITE Applicant (Final Approval) - YELLOW Applicant (Conditional Approval) - PINK