# IREDELL COUNTY HEALTH DEPARTMENT

STATESVILLE 704-878-5305 MOORESVILLE 704-664-5281

## IMPROVEMENT PERMIT / AUTHORIZATION TO CONSTRUCT / OPERATION PERMIT / EXISTING SYSTEM INSPECTION

PERMIT# 98609 PIN# 4708 95 7118 (PT) DATE 1-19-99

OWNER OR CONTRACTOR WALTER ADAMS PHONE: Business Home (828) 632-6286

ADDRESS 128 TOM MEADOWS ROAD, HIDDENITE NC 28636

LOCATION NC 115 N, TL ASCAH, TL LIBERTY HILL, TR KNOLLWOOD DR, BEAR (L), MH on (R)

SUBDIVISION BLOCK / SECTION LOT LOT AREA 83.29 ACRES SITE CLASS PS DESIGN FLOW 360' L.T.A.R. 0.30 GPD/FT

Septic Tank: 1000 Gallons; STB 1012 Date 10-19-98

Pump Tank: Gallons; PT Date

Pump Make: Model Serial No.

Nitrification Field: No. Fields 1 Square Feet 1200 Linear Feet 400

No. Lines FOUR Trench Width 36" Max Trench Bottom Depth 36" Gravel Depth 12"

[X] New System [ ] Repair System Type: I, II, III, IV, V

System Description: CONVENTIONAL GRAVITY

Repair System Description: CONV. GRAVITY

Maintenance Agreement Required: [ ] Yes [X] No

[ ] House/Mod. Home No. Bedrooms 3

[X] Mobile Home No. Bathrooms 2

[ ] Business No. Employees

[ ] Other

[ ] Slab [X] Crawl Space [ ] Basement w/plumbing [ ] Basement wo/plumbing


Water Supply: [X] Individual [ ] Public [ ] Community

WELL NEAR DOOR


Comments:/Conditions:

Comments:/Conditions:

INITIAL SITE SKETCH

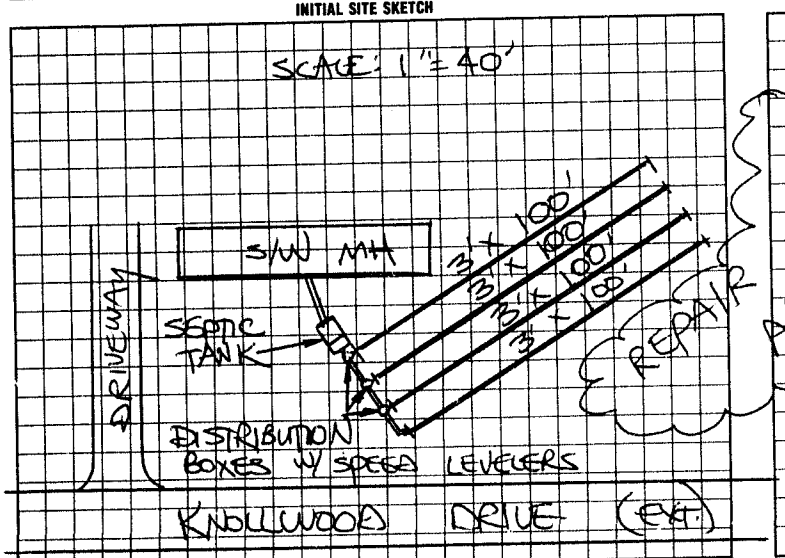


AS BUILT SKETCH

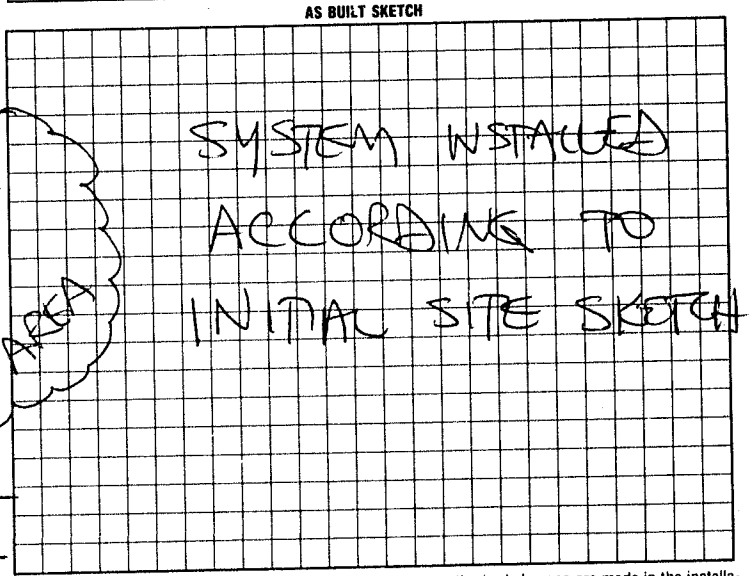


I understand that this permit can be suspended or revoked if any false information is supplied toward securing the permit/any unauthorized changes are made to the site/any unauthorized changes are made in the installation of the system. Improvement Permit with plat valid without expiration. Improvement Permit with site plan valid for sixty months. Authorization to Construct is valid for a period equal to that of Improvement Permit – not to exceed sixty months.

Signed: Walter J. Adams date 1-19-99

Improvement Permit by: STEVE HEDRICK date 1-19-99

Authorization to Construct by: STEVE HEDRICK date 1-19-99

Installed by: WALTER ADAMS (OWNER)

Operation Permit by: STEVE HEDRICK date 2-12-99

Existing System Inspection by: date

HEALTH DEPT. COPY: WHITE INSPECTION COPY (FINAL): GREEN OWNER COPY (FINAL): YELLOW INSPECTION COPY (INITIAL): PINK OWNER COPY (INITIAL): GOLD