IREDELL COUNTY HEALTH DEPARTMENT

STATESVILLE 704-878-5305 MOORESVILLE 704-664-5281 ✓

IMPROVEMENT PERMIT / AUTHORIZATION TO CONSTRUCT / OPERATION PERMIT / EXISTING SYSTEM INSPECTION

PERMIT# 10268 PIN# 4708-95-7118 DATE 10/11/01

OWNER OR CONTRACTOR Walter Adams PHONE Business — Home (704) 876-1868

ADDRESS 127 Knollwood Dr. Statesville, N.C. 28687

LOCATION 115 N., ⓒ Pisgah Church, ⓒ Liberty Hill, ⓡ Knollwood, 1st ⌂ Rt.

SUBDIVISION — Existing BLOCK / SECTION — LOT — LOT AREA 83.24 SITE CLASS 75 DESIGN FLOW 360 L.T.A.R.

Septic Tank: 4000 Gallons: STB Date

Pump Tank: Gallons: PT Date

Pump Make: Model Serial No. Existing

Nitrification Field: No. Fields 1 Square Feet 1440 Linear Feet 480

No Lines 4 Existing Trench Width Max Trench Bottom Depth Gravel Depth

☐ New System ☐ Repair System Type: I. II. III. IV. V. VI

System Description: Conv. gravity

Repair System Description:

Maintenance Agreement Required: ☐ Yes ☒ No

☐ Slab ☒ Crawl Space ☐ Basement w/plumbing ☐ Basement wo/plumbing

☒ House/Mod. Home No. Bedrooms 3

☒ Mobile Home No. Bathrooms 2

☐ Business No. Employees

☐ Other

Water Supply: ☒ Individual ☐ Public ☐ Community


Comments/Conditions:

Comments/Conditions:

Existing System working Okay at time of inspections. (Ref. Permit # 23804 dated 7/2/96 → Walter J. Adams)

INITIAL SITE SKETCH

AS BUILT SKETCH

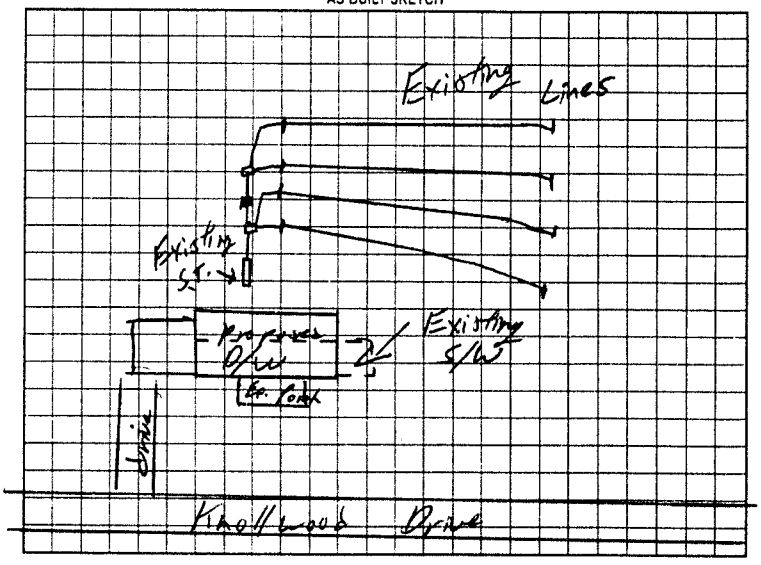

Permit can be suspended or revoked if any false information is supplied toward securing the permit/any unauthorized changes are made to the site/any unauthorized changes are made in the installation of the system. Improvement Permit with plat valid without expiration. Improvement Permit with site plan valid for sixty months. Authorization to Construct is valid for a period equal to that of Improvement Permit – not to exceed sixty months.

Signed: _____ date _____ Installed by: _____

Improvement Permit by: _____ date _____ Operation Permit by: _____ date _____

Authorization to Construct by: _____ date _____ Existing System Inspection by: William O. Johnson date 10/11/01

HEALTH DEPT COPY WHITE OWNER COPY (FINAL) YELLOW OWNER COPY (INITIAL) PINK