IREDELL COUNTY HEALTH DEPARTMENT

STATESVILLE 704-878-5305 MOORESVILLE 704-664-5281

IMPROVEMENT PERMIT / CERTIFICATE OF COMPLETION / OPERATION PERMIT / EXISTING SYSTEM INSPECTION

PROPERTY DESCRIPTION NO. 066635 DATE 5-16-97 TAX MAP NO. 4708964698 Watershed: ☐ WPA ☑ No

OWNER OR CONTRACTOR MICHAEL HARBIN PHONE: Business Home 876-4378

ADDRESS 227 WALKER VALLEY DRIVE, STONY POINT, NC 28678

LOCATION NC 115 N, TL PISGAH, TL LIBERTY HILL, DRIVE ON RIGHT BEFORE BRIDGE, BACK OFF ROAD ~900'

SUBDIVISION BLOCK / SECTION LOT LOT AREA 6 ACRES SITE CLASS. PS DESIGN FLOW 360 L.T.A.R. 0.33 GPD/FT²

Septic Tank: 1000 Gallons; STB W12 Date 8-10-97
Pump Tank: Gallons; PT Date
Pump Make: Model Serial No.
Nitrification Field: No Fields 1 Square Feet 1080 Linear Feet 360
No Lines FOUR Trench Width 36" Max Trench Bottom Depth 36"

☑ New System ☐ Repair System Type: I, II, III, IV, V, VI
System Description: CONVENTIONAL GRAVITY
Repair System Description: CONV. GRAVITY
Maintenance Agreement Required: ☐ Yes ☑ No
Gravel Depth 12


☑ House/Mod. Home No. Bedrooms 3
☑ Mobile Home No. Bathrooms 2
☐ Business No. Employees
☐ Other
☐ Slab ☑ Crawl Space ☐ Basement w/plumbing ☐ Basement wo/plumbing

Water Supply: ☑ Individual ☐ Community ☑ Public WELL

Comments: KEEP SYSTEM MINIMUM 100' FROM WELL ② INSTALL LINES ON CONTOUR AS FLAGGED.

Comments:

INITIAL SITE SKETCH

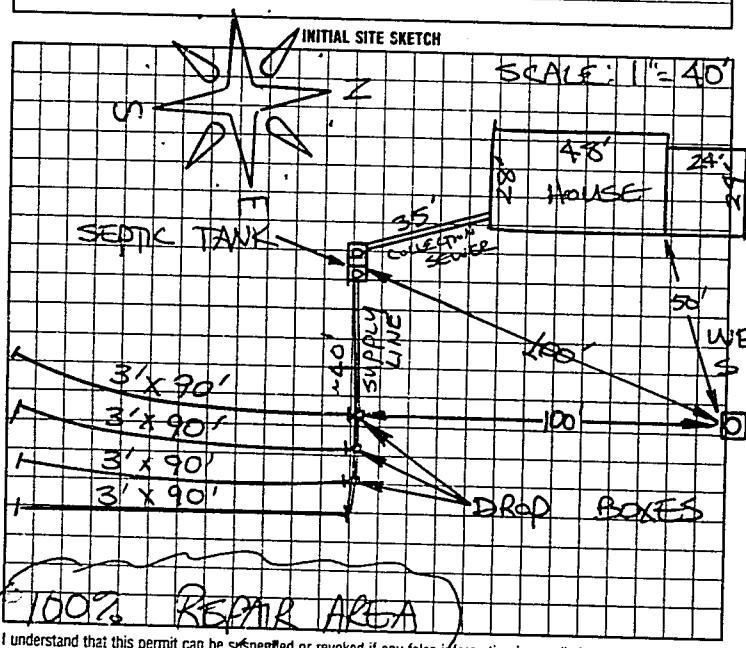

AS BUILT SKETCH

Installed as Shown

I understand that this permit can be suspended or revoked if any false information is supplied toward securing the permit/any unauthorized changes are made to the site/any unauthorized changes are made in the installation of the system. Improvement Permit is valid for 60 months from date of issuance. AUTHORIZATION TO CONSTRUCT IS VALID FOR 60 MONTHS FROM DATE OF ISSUANCE.

Signed: X Michael Harbin

Improvement Permit by: STEVE HEDRICK date 5-16-97

AUTH. TO CONST.

~~Existing System Inspection by:~~ STEVE HEDRICK date 5-16-97

Installed by: Kenny Madison

~~Certificate of Completion by:~~ date

Operation Permit by: Mark C Oaks PS date 11-5-97

HEALTH DEPT. COPY: WHITE INSPECTION COPY (FINAL): GREEN OWNER COPY (FINAL): YELLOW INSPECTION COPY (INITIAL): PINK OWNER COPY (INITIAL): GOLD