# IREDELL COUNTY HEALTH DEPARTMENT

STATESVILLE 704-878-5305 MOORESVILLE 704-664-5281

## IMPROVEMENT PERMIT / AUTHORIZATION TO CONSTRUCT / OPERATION PERMIT / EXISTING SYSTEM INSPECTION

PERMIT# 083318 PIN# 4709 10 7694 DATE 8-13-99

OWNER OR CONTRACTOR GARY HATLEY PHONE: Business Home 876-6061

ADDRESS 858 HARRIS BRIDGE Road STONY POINT, NC 28678

LOCATION NC 115 N, TL MIDWAY RD, TR HARRIS BRIDGE RD, ON RIGHT JUST PAST HATLEY FARM Loop

SUBDIVISION BLOCK / SECTION LOT LOT AREA 3.50 Acres SITE CLASS PS DESIGN FLOW 360 L.T.A.R. 0.33 GPD/FT²

Septic Tank: 1000 Gallons; STB 1012 Date 8-6-99
Pump Tank: Gallons; PT Date
Pump Make: Model Serial No.
Nitrification Field: No Fields 1 Square Feet 1440 Linear Feet 480
No Lines FOUR Trench Width 36" Max Trench Bottom Depth 36" Gravel Depth 12"

✓ New System Repair System Type: I II III IV V VI
System Description: CONVENTIONAL GRAVITY
Repair System Description: CONV. PUMP
Maintenance Agreement Required Yes ✓ No
Slab ✓ Crawl Space Basement w/plumbing Basement wo/plumbing


House/Mod. Home No. Bedrooms 4
✓ Mobile Home No. Bathrooms 2½
Business No. Employees
Other

Water Supply: ☐ Individual ✓ Public ☐ Community

Comments/Conditions


SCALE: 1" = 50'

INITIAL SITE SKETCH

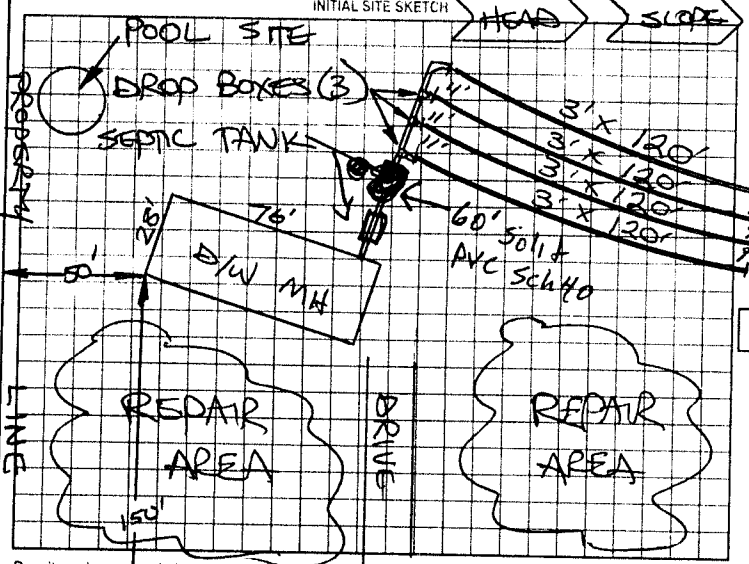


Comments/Conditions

AS BUILT SKETCH

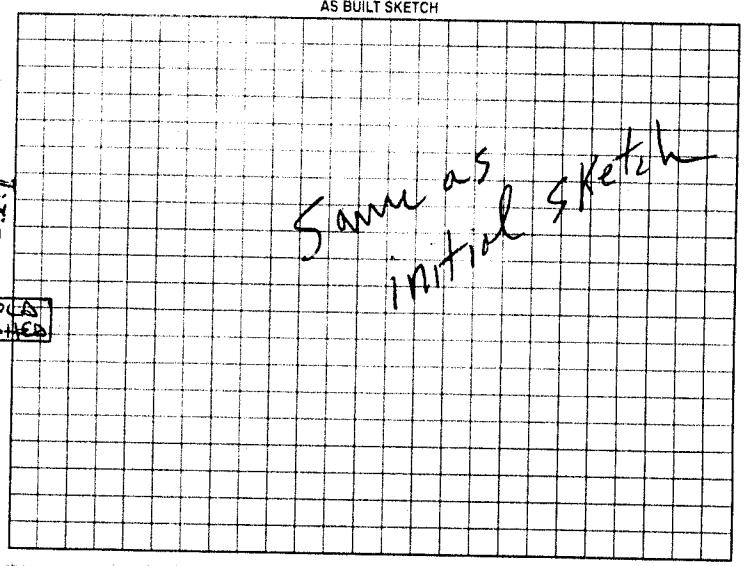


Permit can be suspended or revoked if any false information is supplied toward securing the permit/any unauthorized changes are made to the site/any unauthorized changes are made in the installation of the system. Improvement Permit with plat valid without expiration. Improvement Permit with site plan valid for sixty months. Authorization to Construct is valid for a period equal to that of Improvement Permit - not to exceed sixty months.

Signed: X Sally Hatley date 8-13-99

Improvement Permit by: STEVE HEDRICK date 8-13-99

Authorization to Construct by: STEVE HEDRICK date 8-13-99

Installed by: Tommy Cathcart

Operation Permit by: C. C. Moore date 10-22-99

Existing System Inspection by: date

HARRIS BRIDGE ROAD (SR 1570)

HEALTH DEPT COPY WHITE OWNER COPY (FINAL) YELLOW OWNER COPY (INITIAL) PINK