IREDELL COUNTY HEALTH DEPARTMENT

STATESVILLE 704-878-5305 MOORESVILLE 704-664-5281

IMPROVEMENT PERMIT / AUTHORIZATION TO CONSTRUCT / OPERATION PERMIT / EXISTING SYSTEM INSPECTION

PERMIT# 111514 PIN# ~~4709-10-2694.4~~ 4709-10-7532 DATE 3/14/03

OWNER OR CONTRACTOR J+J Properties PHONE: Business ______ Home (704) 876-4309

ADDRESS 118 Branton Farm Road, Stony Point, N.C. 28678

LOCATION Hwy 90W, (R) Midway, (L) Harris Bridge Rd, (R) Rattley Farm Rd on corner of Harris Bridge Rd

SUBDIVISION Cedar Acres BLOCK / SECTION 1 – LOT 4 LOT AREA .808 Ac. SITE CLASS. PS DESIGN FLOW 360 L.T.A.R. .35 gpd/ft²

Septic Tank: Ex 1,000 Gallons; STB – Date –

Pump Tank: ______ Gallons; PT ______ Date ______

Pump Make: ______ Model ______ Serial No. ______

Nitrification Field: No Fields 1 Square Feet 675 Linear Feet 225

No Lines 2 Trench Width 36" Max Trench Bottom Depth 36" Gravel Depth 12"

☒ New System ☐ Repair System Type: I (II) III, IV, V, VI

System Description: Gravity, Conventional

Repair System Description: Gravity, Conventional

Maintenance Agreement Required: ☐ Yes ☒ No

☐ Slab ☒ Crawl Space ☐ Basement w/plumbing ☐ Basement wo/plumbing

☐ House/Mod. Home ☒ Mobile Home ☐ Business ☐ Other ______


No. Bedrooms 3 No. Bathrooms 2 No. Employees ______

Water Supply: ☐ Individual ☒ Public ☐ Community

Comments:/Conditions: (1) Abandon 1st Line (2) Add 225 ft of Septic lines on contour (3) Replace dist. box with drop boxes (4) Replace old Tee in Tank w/ New Tee + Filter. (5) Maintain proper setbacks with Mobile Home

Comments:/Conditions: – New tee + polylok filter installed in tank – added 230 ft of Septic Lines

INITIAL SITE SKETCH

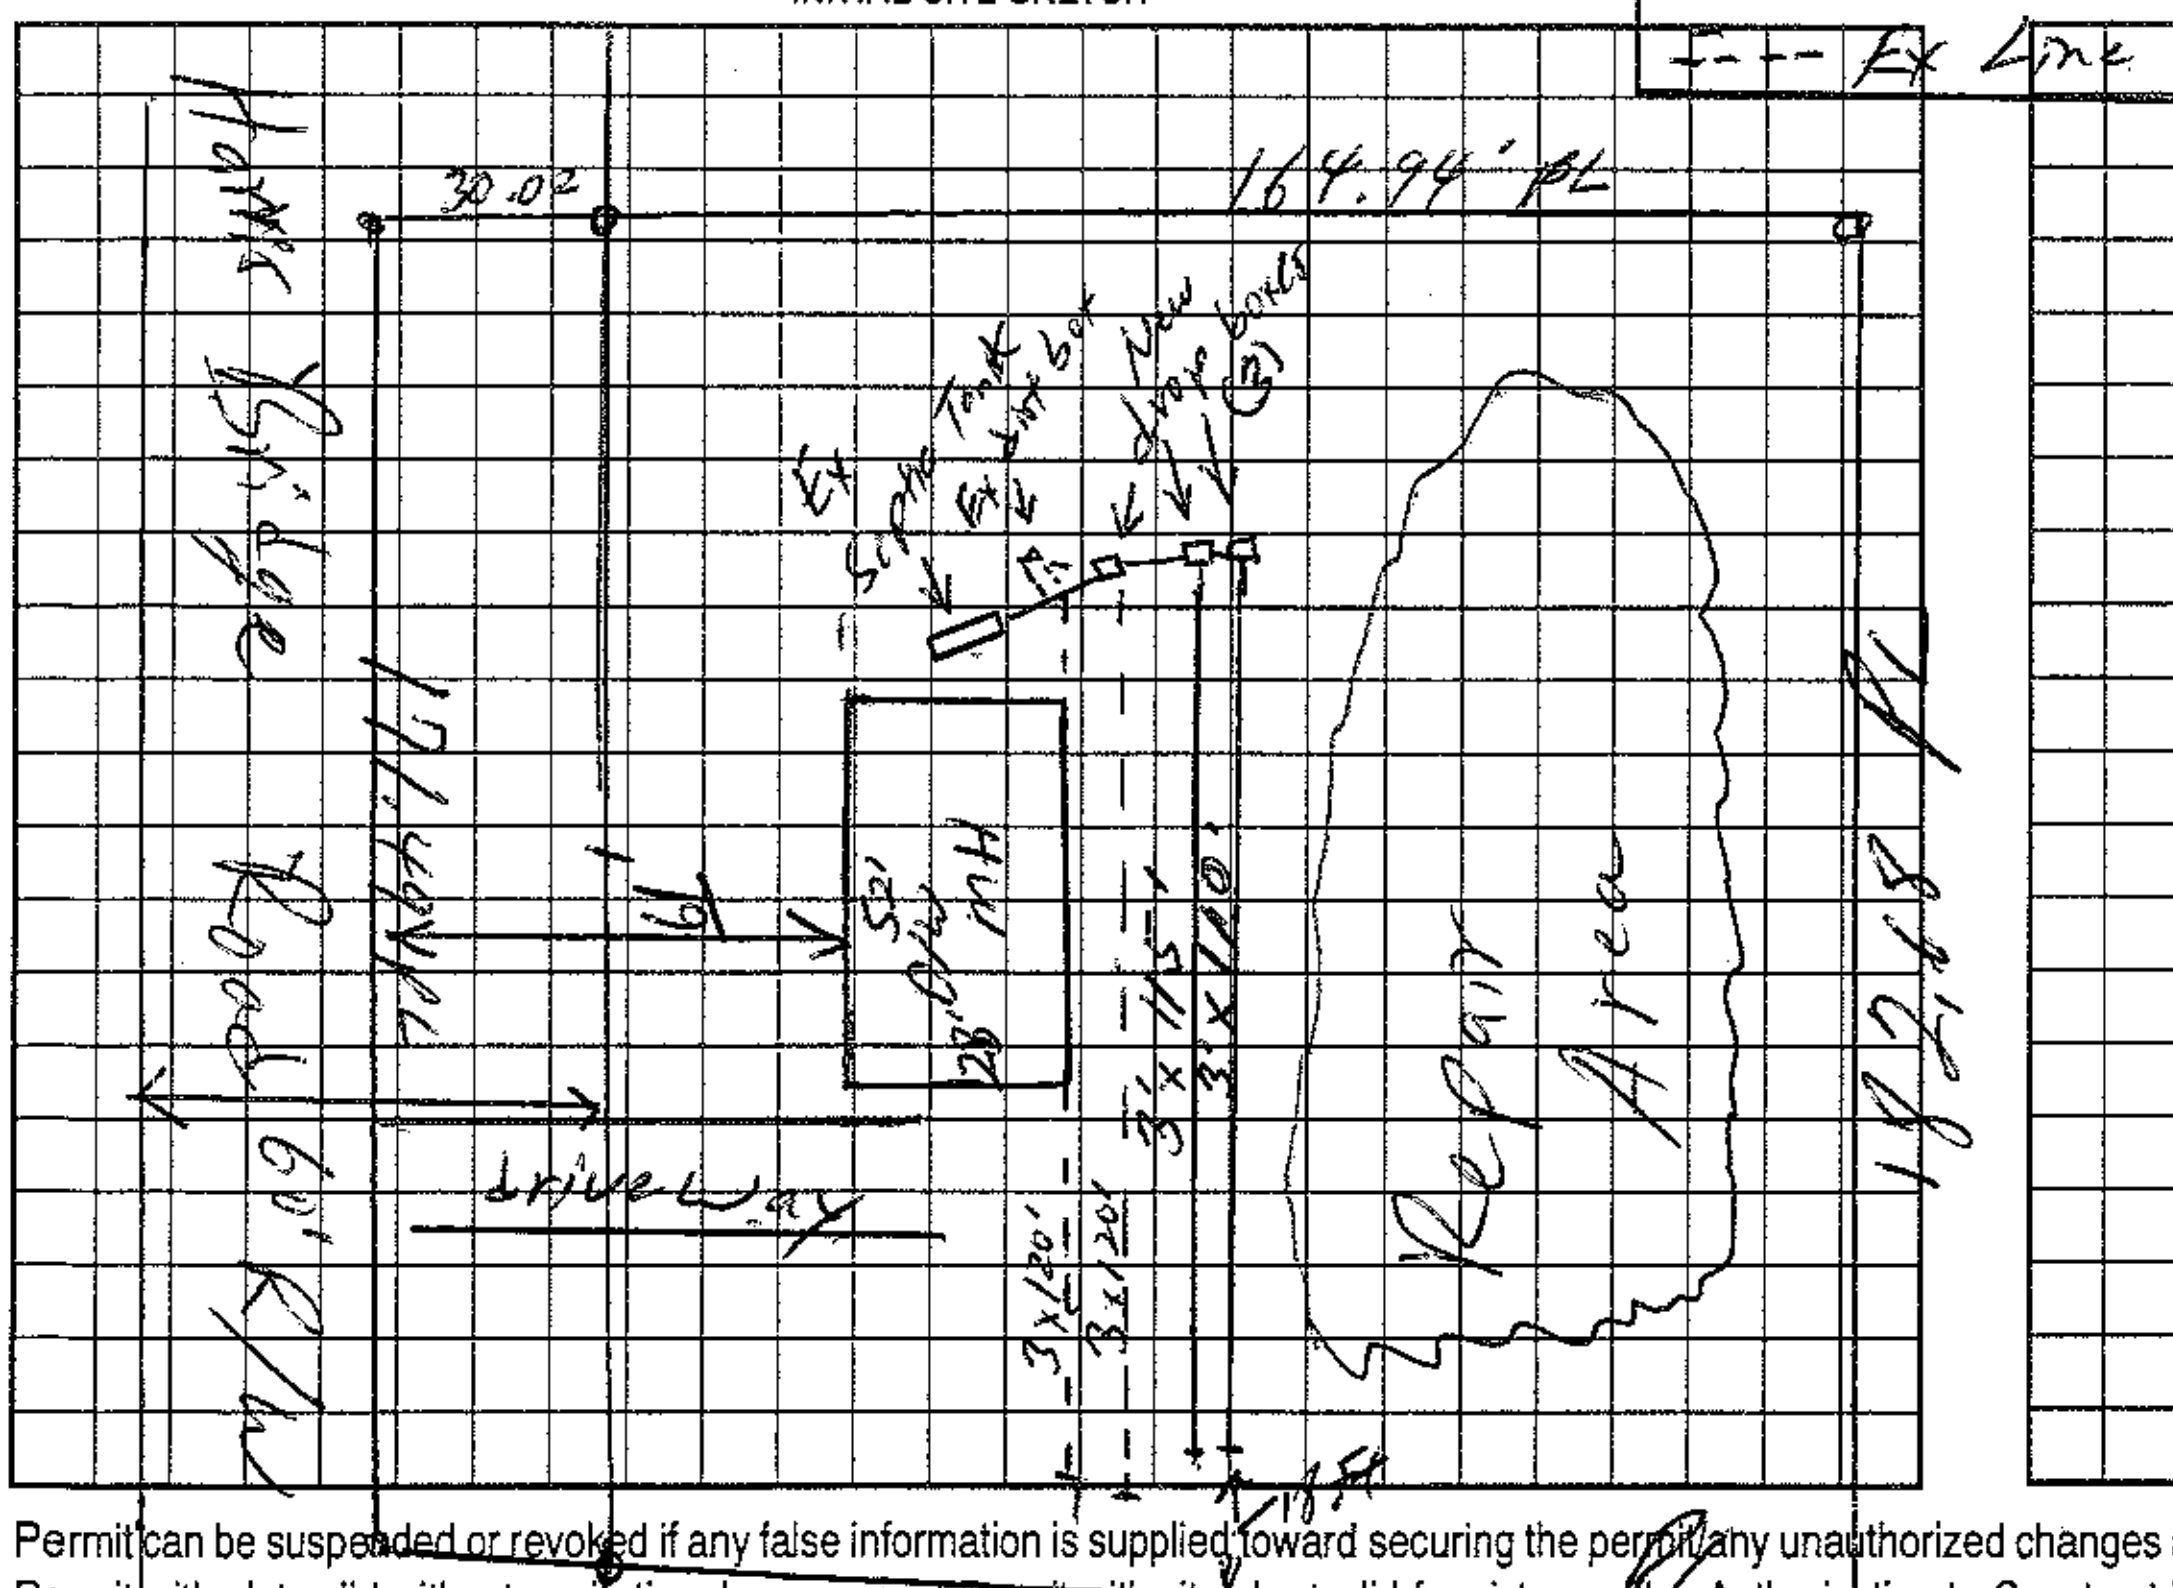

AS BUILT SKETCH

Installed as Shown per Initial Site Sketch

Permit can be suspended or revoked if any false information is supplied toward securing the permit/any unauthorized changes are made to the site/any unauthorized changes are made in the installation of the system. Improvement Permit with plat valid without expiration. Improvement Permit with site plan valid for sixty months. Authorization to Construct is valid for a period equal to that of Improvement Permit – not to exceed sixty months.

Signed: Susan K. Wood date 3/18/03 Installed by: Scott Greene

Improvement Permit by: William O. Johnson date 3/14/03 Operation Permit by: William O. Johnson date 3/14/03

Authorization to Construct by: William O. Johnson date 3/14/03 Existing System Inspection by: ______ date ______

HEALTH DEPT. COPY: WHITE OWNER COPY (FINAL): YELLOW OWNER COPY (INITIAL): PINK