10:00

IREDELL COUNTY HEALTH DEPARTMENT

Statesville Office (704) 878-5305 Mooresville Office (704) 660-3625 PERMIT # 178305

IMPROVEMENT PERMIT / AUTHORIZATION TO CONSTRUCT / OPERATION PERMIT / EXISTING SYSTEM

PIN # 4709114451

APPLICANT: Jill Rufty APPLICANT ADDRESS: 901 Harris Bridge Rd.

SITE ADDRESS: 901 Harris Bridge Rd. PHONE: 704-657-0836 ALT. PHONE: N/A

SITE DIRECTIONS: Hwy 115 N TL Midway Rd TR Harris Bridge Rd.

SUBDIVISION: N/A SECTION: N/A LOT # N/A LOT AREA: 2.2 acres DESIGN FLOW: 360gpd L.T.A.R.: 0.25

Septic Tank 1000 (gal) STB 760 Date 12-10-13
Pump Tank (gal) PT Date
Pump Make Model Serial #
Nitrification Fields 1 # Lines 6 Linear Ft: 340
Trench Width 36" Max. Trench Bottom Depth 36" Gravel Depth N/A


☐ New System ☑ Repair ☐ Expansion System Type: I II (III) IV V VI
System Description:
Repair System Description: 25% Reduction
Maintenance Agreement Required: ☐ YES ☑ NO
☑ GRAVITY ☐ PRESSURE

☑ Residence No. Bedrooms 3
☐ Business No. Persons
☐ Other No. Employees
☐ Slab ☑ Crawl Space
☐ Basement w/plumbing ☐ Basement w/o plumbing


Water Supply: ☑ Private ☐ Public ☐ Community

Comments / Conditions: Pump & crush old septic tank. Install a 25% Reduction system on contour with serial distribution.

INITIAL SITE SKETCH

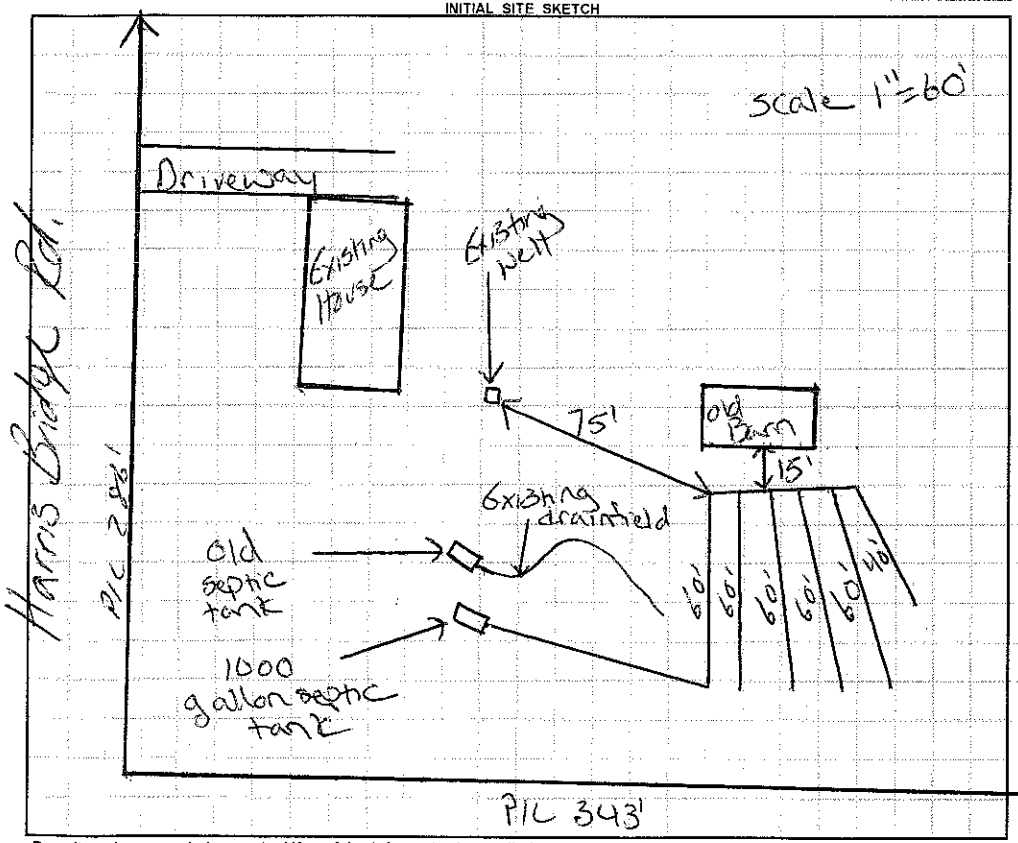

AS BUILT SKETCH

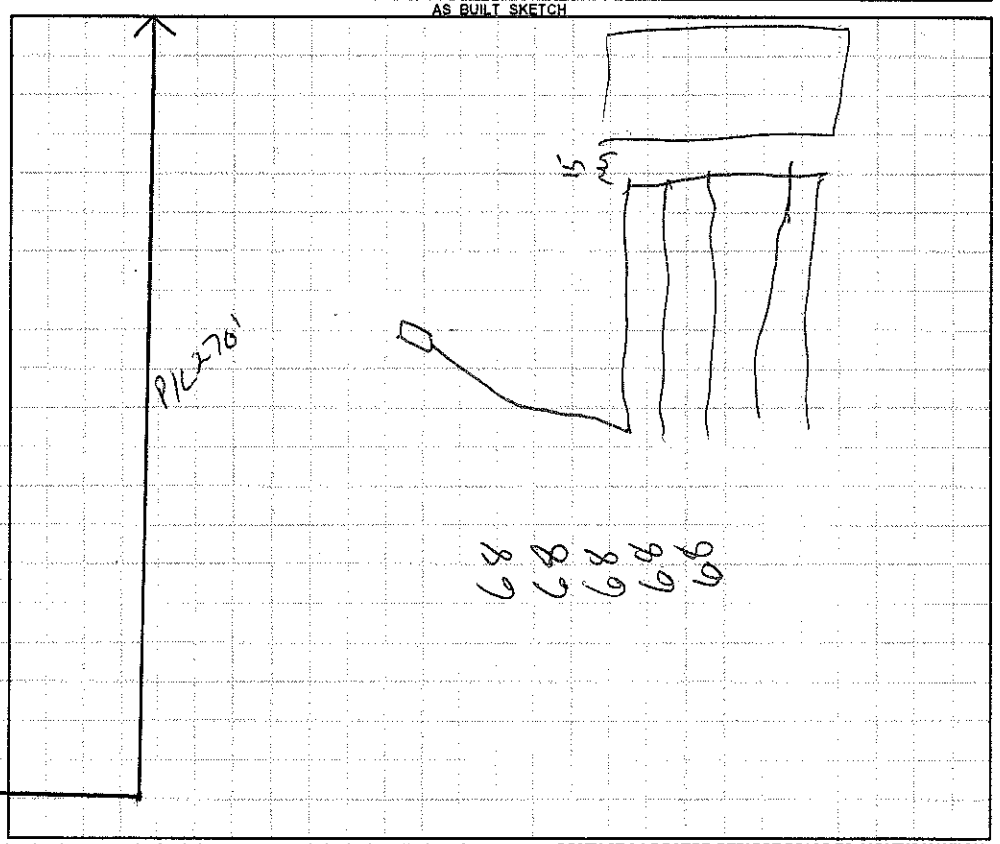

Permit can be suspended or revoked if any false information is supplied toward securing the permit / any unauthorized changes are made to the site / any unauthorized changes are made in the installation of the system. **CONTACT A LOCATOR SERVICE PRIOR TO ANY EXCAVATION**

☐ **IMPROVEMENT PERMIT** *with plat valid without expiration.* ☑ **IMPROVEMENT PERMIT** *with site plan valid for 60 mos.* ☑ **AUTHORIZATION TO CONSTRUCT** *valid for period equal to IMPROVEMENT PERMIT--not to exceed 60 mo.*

Owner / Applicant Signature: Jill M. Rufty Date: 5-21-13 Installed by: A-1 Backhoe

IMPROVEMENT PERMIT by: Justin Henderson Date: 5-17-13 OPERATION PERMIT by: James Date: 6-27-13

AUTHORIZATION TO CONSTRUCT by: Justin Henderson Date: 5-17-13 Existing System Inspected by: Date:

Health Dept. Copy - WHITE Applicant (Final Approval) - YELLOW Applicant (Conditional Approval) - PINK