IREDELL COUNTY HEALTH DEPARTMENT

STATESVILLE 704-878-5305 MOORESVILLE 704-664-5281

IMPROVEMENT PERMIT / AUTHORIZATION TO CONSTRUCT / OPERATION PERMIT / EXISTING SYSTEM INSPECTION

PERMIT# Repair PIN# DATE 3-1-99

OWNER OR CONTRACTOR Wm Stikeleather PHONE: Business Home 876-2831

ADDRESS 1005 Harris Bridge Rd Stony Pt.

LOCATION 115N TL Pisgah Church TL Harris Bridge 1st Brick house on (R)

SUBDIVISION BLOCK / SECTION LOT LOT AREA SITE CLASS DESIGN FLOW 360 L.T.A.R.

Septic Tank: 1000 Gallons; STB Date

Pump Tank: Ex Gallons; PT Date

Pump Make: Model Serial No.

Nitrification Field: No Fields Square Feet Linear Feet 30-40ft

No Lines 1 Trench Width 36in Max Trench Bottom Depth ± 36 Gravel Depth 18 in gravel

[ ] New System [X] Repair System Type: [I] [II] III IV V VI

System Description:

Repair System Description:

Maintenance Agreement Required: [ ] Yes [ ] No

[X] House/Mod. Home [ ] Mobile Home [ ] Business [ ] Other

No. Bedrooms 3 No. Bathrooms 2 No. Employees


[ ] Slab [X] Crawl Space [ ] Basement w/plumbing [ ] Basement wo/plumbing

Water Supply: [X] Individual [ ] Public [ ] Community


Comments/Conditions: Replace first 30-40ft of line - root problem? Need to examine old line may need new drain field

Comments/Conditions: Old Line Dry - * Ran solid pipe from tank to D Box

INITIAL SITE SKETCH

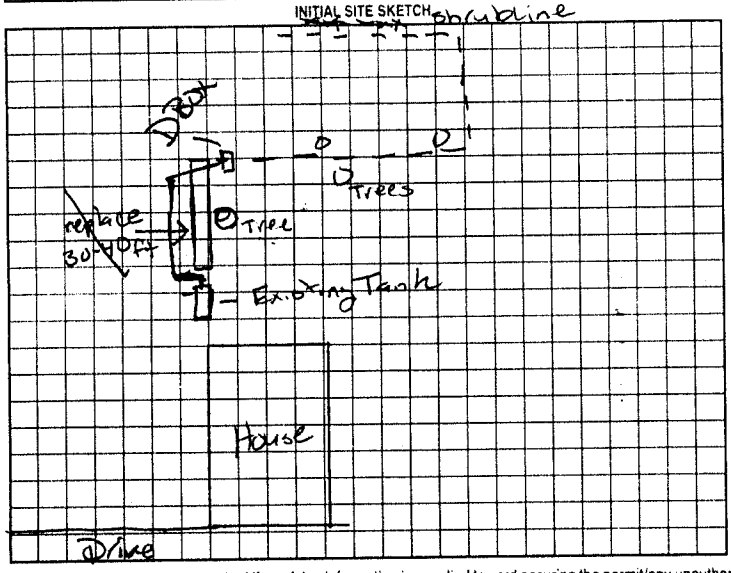

AS BUILT SKETCH

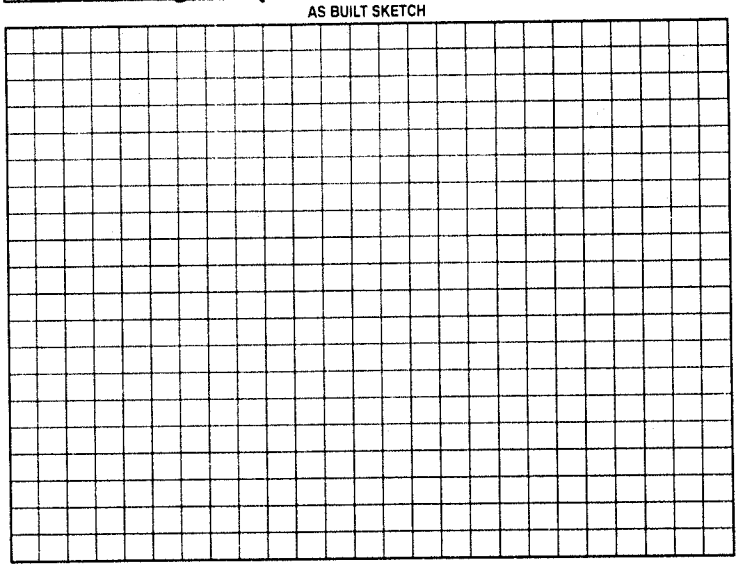

Permit can be suspended or revoked if any false information is supplied toward securing the permit/any unauthorized changes are made to the site/any unauthorized changes are made in the installation of the system. Improvement Permit with plat valid without expiration. Improvement Permit with site plan valid for sixty months. Authorization to Construct is valid for a period equal to that of Improvement Permit – not to exceed sixty months.

Signed: Wm Stikeleather date

Improvement Permit by: May Cox RS date 3-1-99

Authorization to Construct by: May Cox RS date 3-1-99

Installed by: David Yount

Operation Permit by: May Cox RS date 4-9-99

Existing System Inspection by: date

HEALTH DEPT COPY WHITE OWNER COPY (FINAL) YELLOW OWNER COPY (INITIAL) PINK