IREDELL COUNTY HEALTH DEPARTMENT

STATESVILLE 704-878-5305 MOORESVILLE 704-664-5281

IMPROVEMENT PERMIT / AUTHORIZATION TO CONSTRUCT / OPERATION PERMIT / EXISTING SYSTEM INSPECTIO

PERMIT# Repair PIN# DATE 3-1-99

OWNER OR CONTRACTOR Wm Stikeleather PHONE: Business Home 876-2831

ADDRESS 1005 Harris Bridge Rd Stony Pt.

LOCATION 115N TL Pisgah Church TL Harris Bridge 1st Brick house on (R)

SUBDIVISION BLOCK / SECTION LOT LOT AREA SITE CLASS DESIGN FLOW 360 ETAR

Septic Tank 1000 Gallons: STB Date

Pump Tank: Ea Gallons: PT Date

Pump Make: Model Serial No

Nitrification Field: No Fields Square Feet Linear Feet 30-40ft

No Lines 1 Trench Width 36in Max Trench Bottom Depth 36± Gravel Depth 18 in gravel

New System X Repair System Type: I II III IV V

System Description:

Repair System Description:

Maintenance Agreement Required: Yes No

X House/Mod Home No. Bedrooms 3

Mobile Home No Bathrooms 2

Business No Employees

Other

Slab X Crawl Space Basement w/plumbing Basement wo/plumbing


Water Supply X Individual Public Community

Comments/Conditions: Replace first 30-40 ft of line - root? Need to ~~Remove~~ examine old line Problem? may need new drain ~~lines~~ field

Comments Conditions

* Old Line Dry - Ran solid pipe from tank to ~~tee~~ D Box

INITIAL SITE SKETCH shoreline

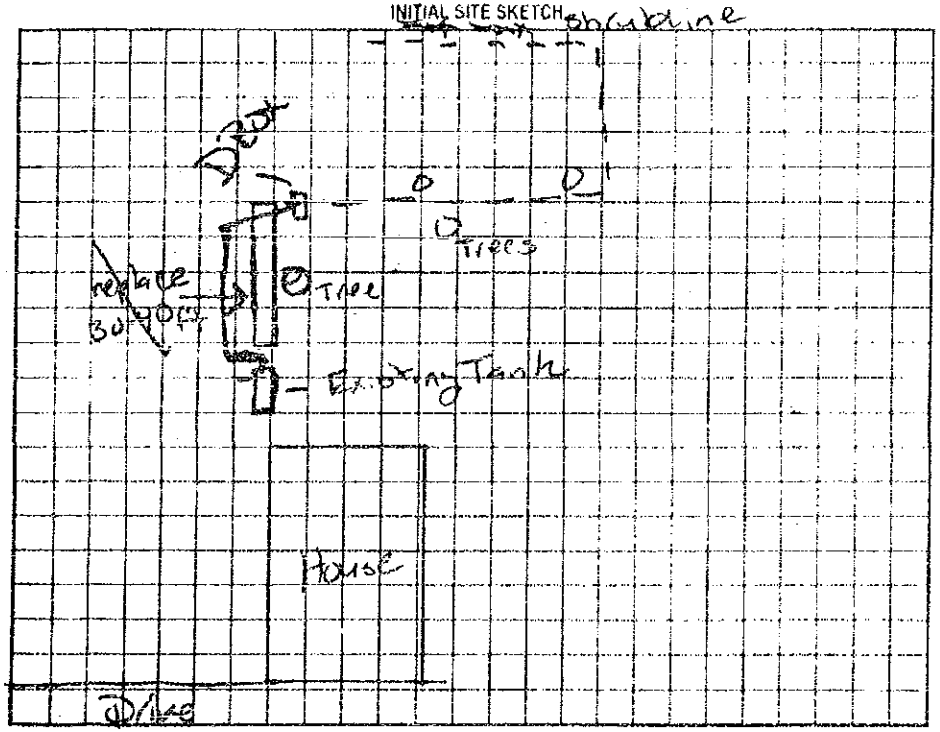

AS BUILT SKETCH

* Please see attached site plan

The proposed GARAGE addition does not appear to impact the existing septic system.

**NOTE: Keep 25'+ from well.

David Yaunty R.S.

Date: 3 April 1999

ICHD-Environmental Health Division

Permit can be suspended or revoked if any false information is supplied toward securing the permit any unauthorized changes are made to the site any unauthorized changes are made in the installation of the system. Improvement Permit with plat valid without expiration. Improvement Permit with site plan valid for sixty months. Authorization to Construct is valid for a period equal to that of Improvement Permit not to exceed sixty months.

Signed: Wm Stikeleather date

Improvement Permit by: Mary Catherine Ott RS date 3-1-99

Authorization to Construct by: Mary Catherine Ott RS date 3-1-99

Installed by: David Yaunty

Operation Permit by: Mary Catherine Ott RS date 4-9-99

Existing System Inspection by: date

HEALTH DEPT COPY WHITE OWNER COPY (FINAL) YELLOW OWNER COPY (INSTALL) PINK

JAN. 27, 1989 4:28