IREDELL COUNTY HEALTH DEPARTMENT

STATESVILLE 704-878-5305 MOORESVILLE 704-664-5281

IMPROVEMENT PERMIT / AUTHORIZATION TO CONSTRUCT / OPERATION PERMIT / EXISTING SYSTEM INSPECTIO

PERMIT# Repair PIN# DATE 3-1-99

OWNER OR CONTRACTOR Wm Stikeleather PHONE Business Home 876-2431

ADDRESS 1005 Harris Bridge Rd. Stan Pl.

LOCATION 115N TL Pisgah Church TL Harris Bridge 1st Brick house (L)

SUBDIVISION BLOCK / SECTION LOT LOT AREA SITE CLASS DESIGN FLOW 360 I TAP

Septic Tank 1000 Gallons STR Date

Pump Tank Gallons PT Date

Pump Make Model Serial No

Application Field No Fields Square Feet Linear Feet 30-40ft

Lines 1 Trench Width 36in Max Trench Bottom Depth 36" Gravel Depth 18in gravel Slab X Crawl Space Basement w/plumbing Basement w/o plumbing

New System X Re... System Type I

System Description

Repair System Description

Maintenance Agreement Required Yes No

House/Mod Home No Bedrooms 3

Mobile Home No Bathrooms 2

Business No Employees

Other

Water Supply

X Individual

Public


Community

Comments/Conditions Replace first 30-40ft of line - root problem. Need to examine old line. May need new drain field

Comments Conditions

* Old Line Dry -
* Ran solid pipe from tank to new D box

INITIAL SITE SKETCH

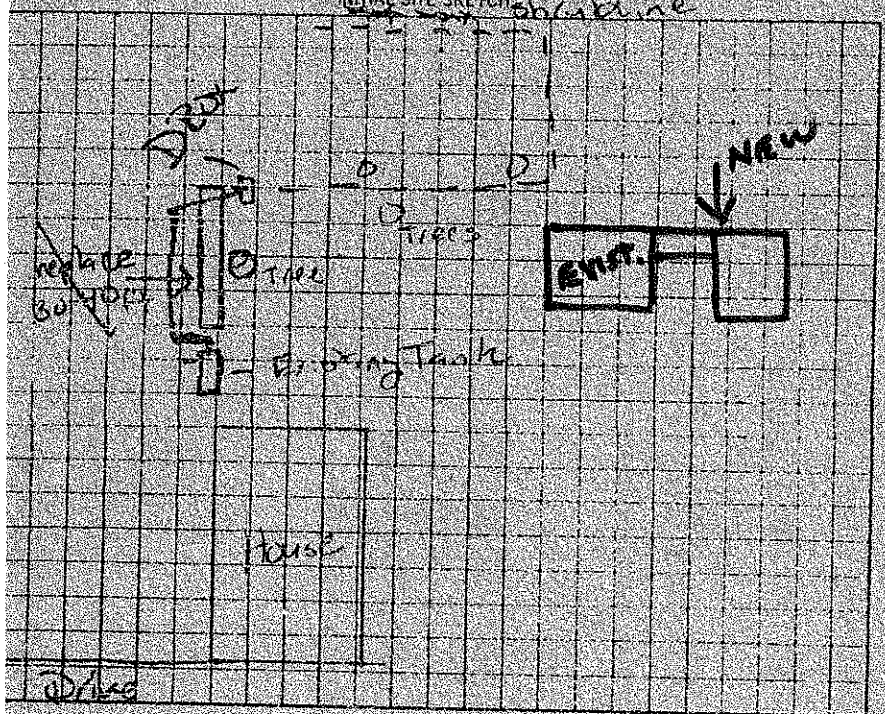

AS BUILT SKETCH

* Please see Attached
Sketch plan

Location of the proposed garage addition (616sf addition does not appear to impact the existing on-site septic system.**NOTE:

REHS

Date: 8-2-12

ICHD-Environmental Health Division

can be suspended or revoked if any false information is supplied toward securing the permit, any unauthorized changes are made to the site any unauthorized changes are made in the installation of the system. Improvemer with plat valid without expiration. Improvement Permit with site plan valid for sixty months. Authorization to Construct is valid for a period equal to that of Improvement Permit not to exceed sixty months.

Installed by David Yountz

vement Permit by May Cox RS date 3-1-99

zation to Construct by May Cox RS date 3-1-99

Operation Permit by May Cox RS date 4-9-99

Existing System Inspection by date

HEALTH DEPT COPY (WHITE) OWNER COPY (FINAL) YELLOW OWNER COPY (INITIAL) PINK

JAN 27, 1989 4:28