IREDELL COUNTY HEALTH DEPARTMENT

STATESVILLE 704-878-5305 MOORESVILLE 704-664-5281

IMPROVEMENT PERMIT / AUTHORIZATION TO CONSTRUCT / OPERATION PERMIT / EXISTING SYSTEM INSPECTION

PERMIT# 127272 PIN# 4709-34-~~2276~~ 8477 DATE 4-19-05

OWNER OR CONTRACTOR CHRIS WALKER PHONE: Business (704) 883-8228 Home

ADDRESS 119 BEECHNUT LANE STATESVILLE NC 28677

LOCATION HWY 115 N TL PISGAH RD. APPROX. 4 MILES ON RIGHT (1186 PISGAH RD)

SUBDIVISION BLOCK / SECTION LOT LOT AREA 59.7 SITE CLASS. PS DESIGN FLOW 360 L.T.A.R. EXISTING

Septic Tank: EXISTING Gallons; STB Date

Pump Tank: Gallons; PT Date

Pump Make: Model Serial No.

Nitrification Field: No Fields Square Feet Linear Feet

No Lines Trench Width Max Trench Bottom Depth Gravel Depth

☐ New System ☐ Repair System Type: I (II) III, IV, V, VI

System Description: EXISTING

Repair System Description:

Maintenance Agreement Required: ☐ Yes ☐ No

☐ House/Mod. Home ☑ Mobile Home ☐ Business ☐ Other No. Bedrooms 3 No. Bathrooms No. Employees


☐ Slab ☑ Crawl Space ☐ Basement w/plumbing ☐ Basement wo/plumbing

Water Supply: ☑ Individual ☐ Public ☐ Community


Comments:/Conditions:

Comments:/Conditions: ① SYSTEM FUNCTIONING PROPERLY AT TIME OF INSPECTION
② PERMISSION TO CONNECT NEW STRUCTURE TO EXISTING SYSTEM
③ STRUCTURE SHALL NOT INCREASE NUMBER OF BEDROOMS ON SYSTEM
④ VISUAL INSPECTION ONLY / NO GUARANTEE PROBLEMS WILL NOT ARISE IN FUTURE

INITIAL SITE SKETCH

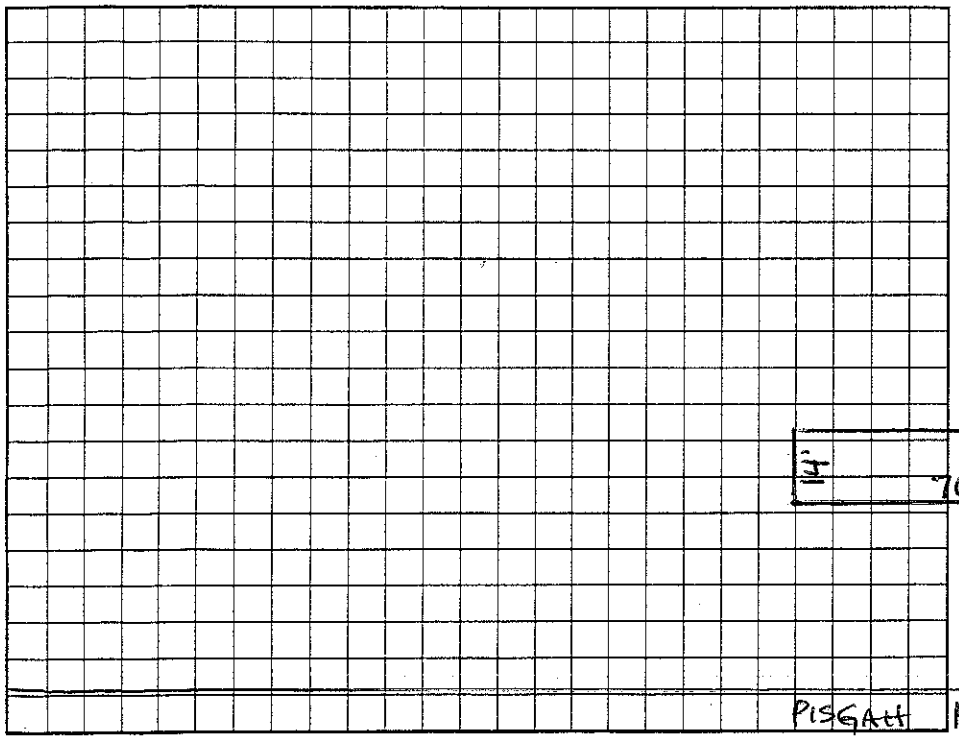

AS BUILT SKETCH

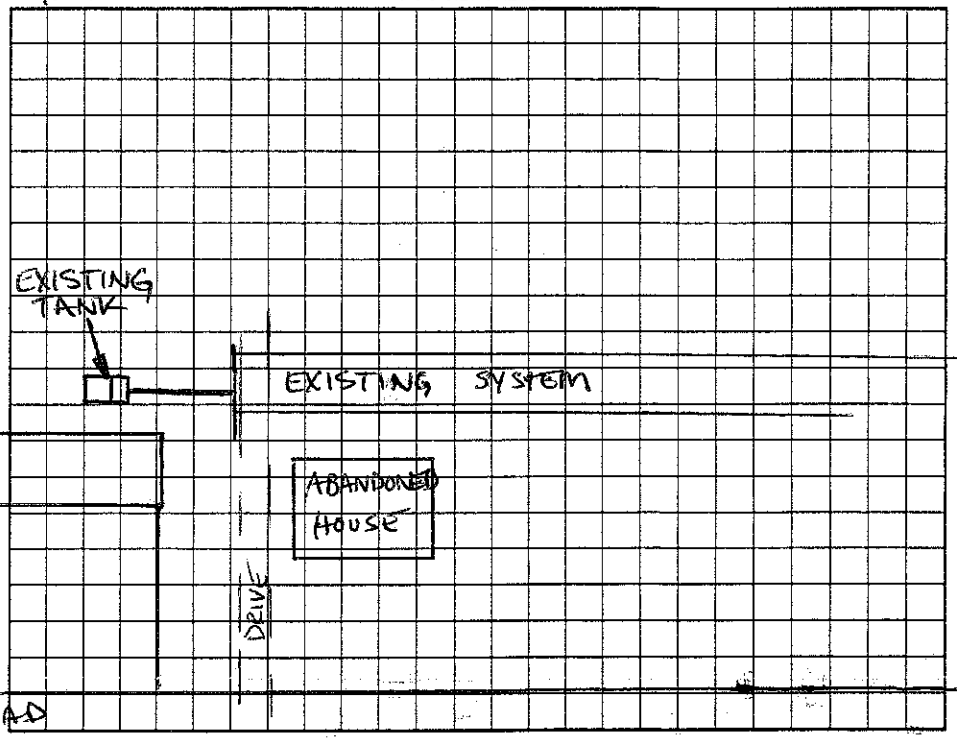

Permit can be suspended or revoked if any false information is supplied toward securing the permit/any unauthorized changes are made to the site/any unauthorized changes are made in the installation of the system. Improvement Permit with plat valid without expiration. Improvement Permit with site plan valid for sixty months. Authorization to Construct is valid for a period equal to that of Improvement Permit – not to exceed sixty months.

Signed: Chris M Walker date 4-19-05

Improvement Permit by: date

Authorization to Construct by: date

Installed by:

Operation Permit by: date

Existing System Inspection by: Christopher M. Sherrill, LSS date 4-19-05

HEALTH DEPT. COPY: WHITE OWNER COPY (FINAL): YELLOW OWNER COPY (INITIAL): PINK