IREDELL COUNTY HEALTH DEPARTMENT

STATESVILLE 704-878-5305 MOORESVILLE 704-664-5281

IMPROVEMENT PERMIT / AUTHORIZATION TO CONSTRUCT / OPERATION PERMIT / EXISTING SYSTEM INSPECTION

(C1)

PERMIT# 136408 PIN# 4709-42-1245 DATE 6-26-06

OWNER OR APPLICANT CLARENCE E. PITTS PHONE: Business Home 704-876-1755

ADDRESS 159 POVERTY HILL LANE, STATESVILLE, NC 28625

LOCATION NC 115 N, TL PISGAH ROAD, 4.0 MILES ON LEFT AT BOX #1085, BACK OFF ROAD 600'


SUBDIVISION BLOCK / SECTION LOT LOT AREA 12.01 ACRES SITE CLASS. PS DESIGN FLOW 360 L.T.A.R. 0.30 GPD/FT²

Septic Tank: 1000 Gallons: STB TP102-100 Date 5-10-06	☑ New System ☐ Repair ☐ Expansion System Type: I (II) III IV V VI	☑ House/Mod. Home No. Bedrooms 3	Water Supply: ☑ Individual
Pump Tank: Gallons: PT Date	System Description: 25% REDUCTION, EQUITY	☐ Mobile Home No. Persons	☐ Public
Pump Make: Model Serial No.	Repair System Description: 25% REDUCTION, GRAVITY	☐ Business No. Employees	☐ Community WELL
Nitrification Field: No Fields 1 Square Feet EQ TO 1,200 Linear Feet 300	Maintenance Agreement Required: ☐ Yes ☑ No	☐ Other	
No Lines THREE Trench Width 36" Max Trench Bottom Depth 36"	Gravel Depth N/A ☑ Gravity ☐ Pressure	☐ Slab ☑ Crawl Space ☐ Basement w/plumbing ☐ Basement wo/plumbing	


Comments:/Conditions: INSTALL 25% REDUCTION SYSTEM ON CONTOUR AS FLAGGED KEEP SYSTEM MINIMUM 100' FROM WELL

Comments:/Conditions: Installed as drawn on site plan.
* well not yet installed.

INITIAL SITE SKETCH

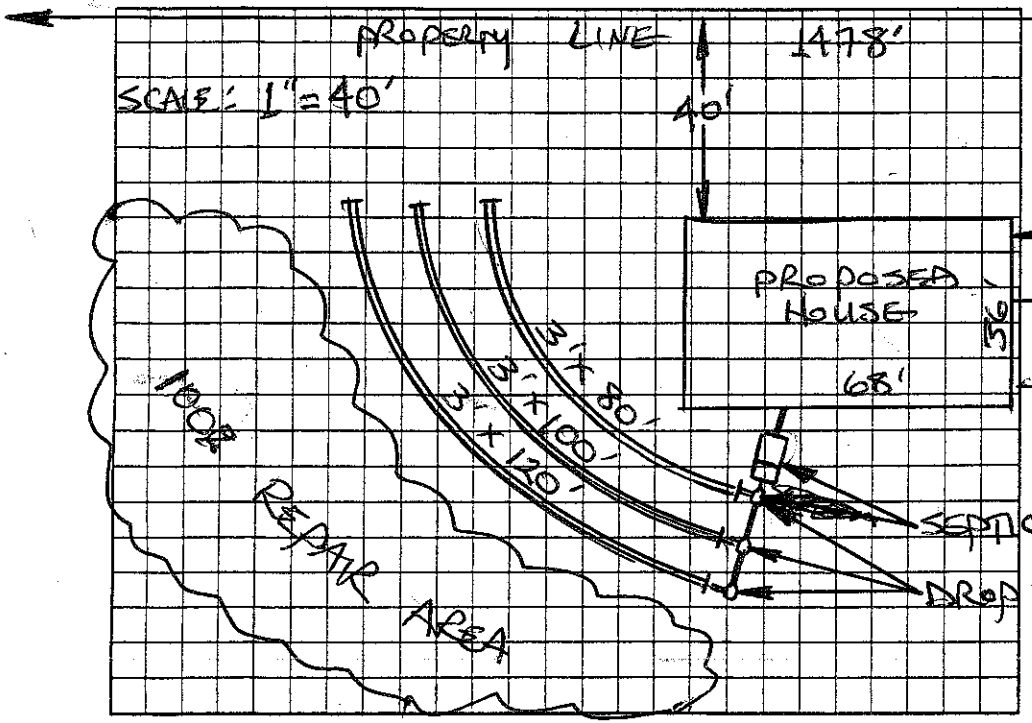

AS BUILT SKETCH

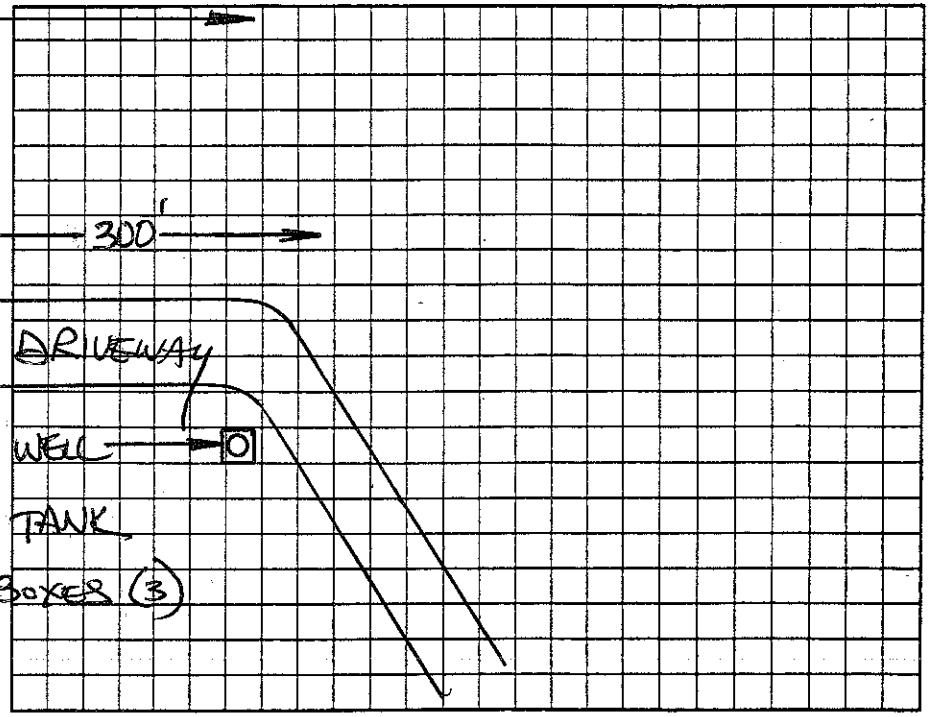

Permit can be suspended or revoked if any false information is supplied toward securing the permit/any unauthorized changes are made to the site/any unauthorized changes are made in the installation of the system. Improvement Permit with plat valid without expiration. ☐ Improvement Permit with site plan valid for sixty months ☑ Authorization to Construct is valid for a period equal to that of Improvement Permit – not to exceed sixty months.

Signed: Clarence Pitts date 6.26.06 Installed by: Craig Thompson

Improvement Permit by: STEVE HEDRICK date 6-26-06 Operation Permit by: [illegible], R.S. date 12 Sept 06

Authorization to Construct by: STEVE HEDRICK date 6-26-06 Existing System Inspection by: date

HEALTH DEPT. COPY: WHITE OWNER COPY (FINAL): YELLOW OWNER COPY (INITIAL): PINK