1130-2100

IREDELL COUNTY HEALTH DEPARTMENT

Statesville Office (704) 878-5305 Mooresville Office (704) 660-3625 PERMIT # 220710

IMPROVEMENT PERMIT / AUTHORIZATION TO CONSTRUCT / OPERATION PERMIT / EXISTING SYSTEM

PIN # 4709-43-1101

APPLICANT: Oakwood Homes of Newton APPLICANT ADDRESS: 1265 Hwy 70W

SITE ADDRESS: 1084 Harris Bridge Rd. ~~Stone Brook Subd.~~ PHONE: 828-464-2602 ALT. PHONE:

SITE DIRECTIONS: 40E, TL Hwy 64, TR Hwy 90, TR Midway, TL Harris Bridge

SUBDIVISION: Stone Brook / Daniel Lee Levan SECTION: LOT # 3-1 LOT AREA: 1.4AC DESIGN FLOW: 360 L.T.A.R.: .3


Septic Tank	1000 (gal)	STB	1000	Date	10-12-16	☑ New System ☐ Repair ☐ Expansion	System Type: I II III IV V VI	☑ Residence	No. Bedrooms 3
Pump Tank	(gal)	PT		Date		System Description:	25% Reduction	☐ Business	No. Persons 6
Pump Make		Model		Serial #		Repair System Description:	Same	☐ Other	No. Employees
# Nitrification Fields	1	# Lines	4	Linear Ft:	300'	Maintenance Agreement Required:	☐ YES ☑ NO	☐ Slab	☑ ~~Crawl Space~~
Trench Width	36"	Max. Trench Bottom Depth	36"	Gravel Depth	—	☑ GRAVITY	☐ PRESSURE	☐ Basement w/ plumbing	☐ Basement w/o plumbing

Water Supply: ☐ Private ☑ Public ☐ Community


Comments / Conditions: Used Quick 4

Front porch not installed yet but left room for 6X6

INITIAL SITE SKETCH

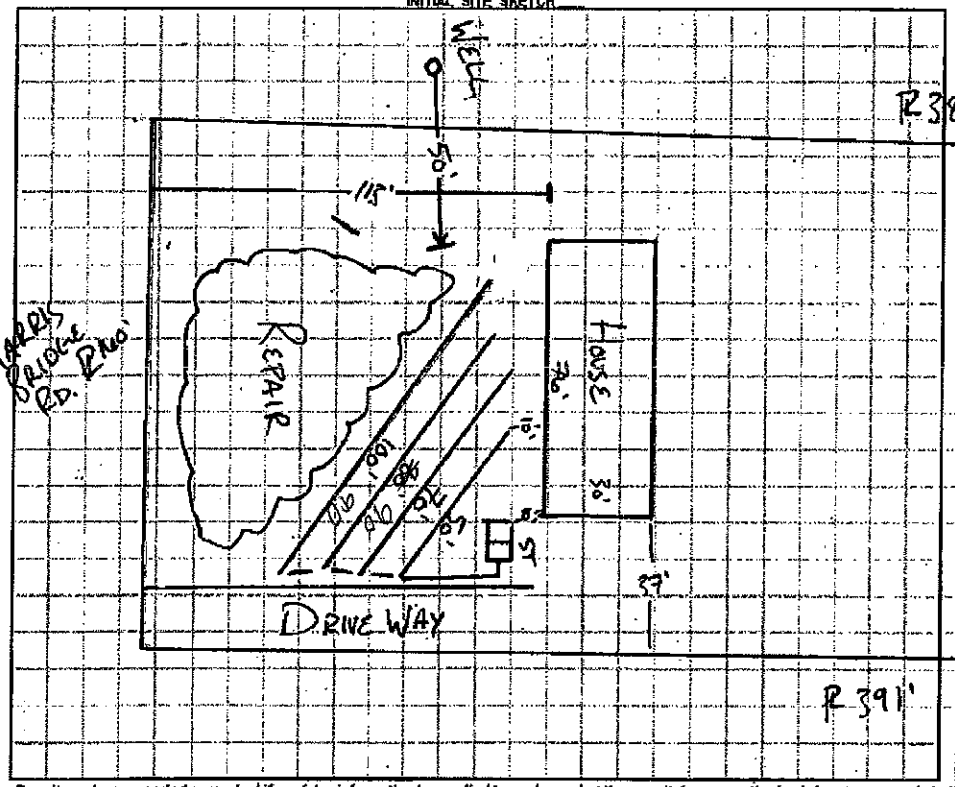

AS BUILT SKETCH

 

Permit can be suspended or revoked if any false information is supplied toward securing the permit / any unauthorized changes are made to the site / any unauthorized changes are made in the installation of the system. **CONTACT A LOCATOR SERVICE PRIOR TO ANY EXCAVATION**

☐ **IMPROVEMENT PERMIT** *with plat valid without expiration.* ☑ **IMPROVEMENT PERMIT** *with site plan valid for 60 mos.* ☑ **AUTHORIZATION TO CONSTRUCT** *valid for period equal to IMPROVEMENT PERMIT--not to exceed 60 mo.*

Owner / Applicant Signature: Date: Installed by: Abee Landscaping

IMPROVEMENT PERMIT by: RA Date: 9-27-16 OPERATION PERMIT by: Maria Dotson RS Date: 11/4/17

AUTHORIZATION TO CONSTRUCT by: RA Date: 9-29-16 Existing System Inspected by: Date:

Health Dept. Copy - WHITE Applicant (Final Approval) - YELLOW Applicant (Conditional Approval) - PINK