IREDELL COUNTY HEALTH DEPARTMENT

STATESVILLE 704-878-5305 MOORESVILLE 704-664-5281

IMPROVEMENT PERMIT / AUTHORIZATION TO CONSTRUCT / OPERATION PERMIT / EXISTING SYSTEM INSPECTION

PERMIT# 124/19 PIN# 4709-43-2039.002 3190 DATE 11-2-04

OWNER OR CONTRACTOR DANIEL LEVAN PHONE: Business Home (704) 876-8728

ADDRESS 1090 HARRIS BRIDGE RD STONY POINT NC 28678

LOCATION 115 N TL PISGAH TL HARRIS BRIDGE 1st ON LT

SUBDIVISION Levan Property BLOCK / SECTION LOT 3 LOT AREA 4.33 SITE CLASS. PS DESIGN FLOW 240 L.T.A.R. 0.3 gpd/ft²

Septic Tank 1000 Gallons; STB 1007 Date 10-27-04

Pump Tank Gallons; PT Date

Pump Make Model Serial No.

Nitrification Field: No Fields 1 Square Feet 800 Linear Feet 270'

No Lines 3 Trench Width 36" Max Trench Bottom Depth 24" Gravel Depth 12"

☑ New System ☐ Repair System Type: I, (II), III, IV, V, VI

System Description: CONVENTIONAL GRAVITY

Repair System Description: PUMP 25% REDUCTION

Maintenance Agreement Required: ☐ Yes ☑ No

☐ House/Mod. Home No. Bedrooms 2

☑ Mobile Home No. Bathrooms

☐ Business No. Employees

☐ Other


☐ Slab ☑ Crawl Space ☐ Basement w/plumbing ☐ Basement wo/plumbing

Water Supply: ☐ Individual ☑ Public ☐ Community


Comments/Conditions: ① INSTALL ON CONTOUR ② MAINTAIN SETBACKS

Comments/Conditions: SEPTIC TANK WITH MARKER INSTALLED USING "EZABEL" FILTER

INITIAL SITE SKETCH 1"= 50'

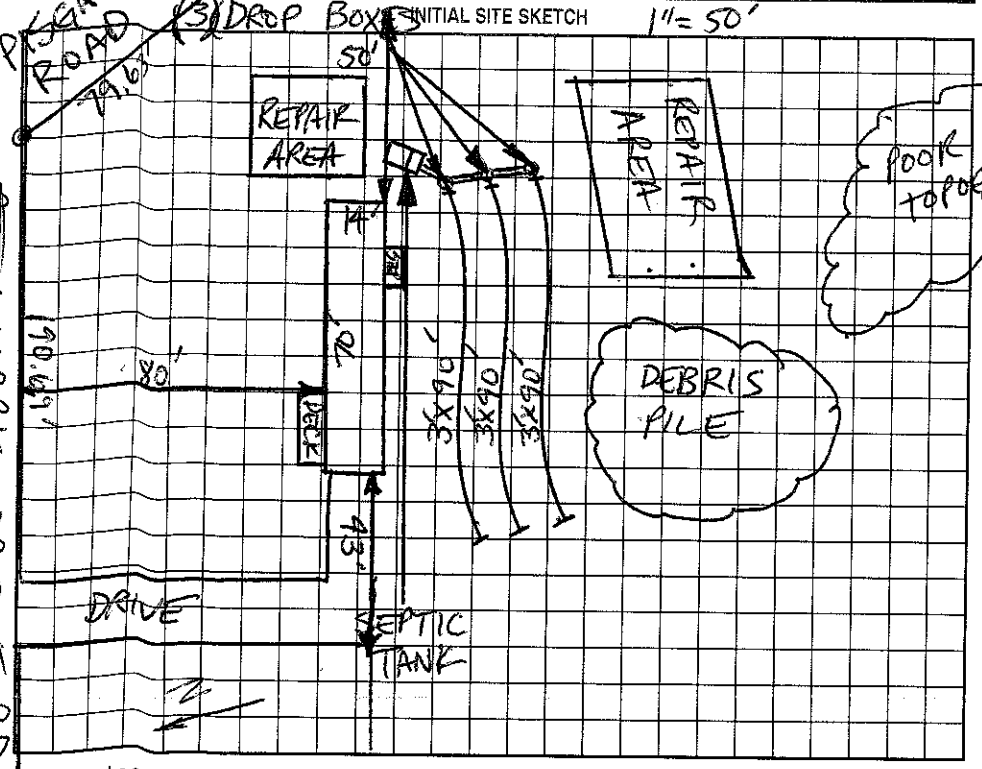

AS BUILT SKETCH

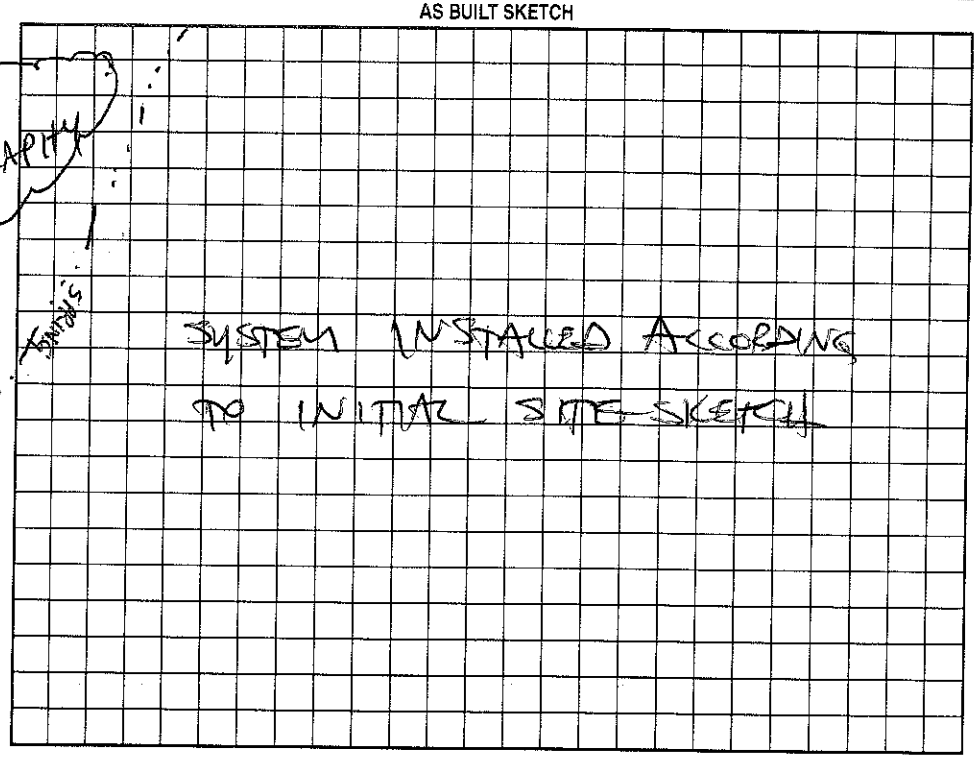

Permit can be suspended or revoked if any false information is supplied toward securing the permit/any unauthorized changes are made to the site/any unauthorized changes are made in the installation of the system. Improvement Permit with plat valid without expiration. Improvement Permit with site plan valid for sixty months. Authorization to Construct is valid for a period equal to that of Improvement Permit – not to exceed sixty months.

Signed: date 11-8-04

Improvement Permit by: date 11-2-04

Authorization to Construct by: date 11-2-04

Installed by: ANDY DANIELS

Operation Permit by: STEVE HEDRICK date 1-06-05

Existing System Inspection by: date

HEALTH DEPT. COPY: WHITE OWNER COPY (FINAL): YELLOW OWNER COPY (INITIAL): PINK