IREDELL COUNTY HEALTH DEPARTMENT

See attached building addition.

STATESVILLE 704-878-5305 MOORESVILLE 704-664-5281

IMPROVEMENT PERMIT / AUTHORIZATION TO CONSTRUCT / OPERATION PERMIT / EXISTING SYSTEM INSPECTION

PERMIT# 121792 PIN# 4709-38-9990 480936 DATE 2-3-05

OWNER OR CONTRACTOR TOBY & ALLISON BOLICK PHONE: Business (704) 873-3250 Home (704) 878-9936

ADDRESS 139 SIGMON RIDGE DR. STATESVILLE NC 28677

LOCATION HWY 115 N TL PISGAH RD TR JOHNSON FARM RD 4TH LOT ON RT - Site address: 339 Johnson Farm Rd.

SUBDIVISION _____ BLOCK / SECTION _____ LOT _____ LOT AREA 7.11 SITE CLASS. PS DESIGN FLOW 360 L.T.A.R. 0.30 gpd/ft²

Septic Tank: 1000 Gallons; STB 825 Date 3-11-05
Pump Tank: 1000 Gallons; PT 302 Date 2-6-05
Pump Make: Zoeller Model N-152 Serial No. _____
Nitrification Field: No Fields 1 Square Feet 1200 Linear Feet 300
No Lines 3 Trench Width 36" Max Trench Bottom Depth 20" Gravel Depth N/A

☑ New System ☐ Repair System Type: I, II, III, IV, V, VI
System Description: PUMP 25% REDUCTION
Repair System Description: MODIFIED LOW-PRESSURE
Maintenance Agreement Required: ☐ Yes ☑ No

☑ House/Mod. Home No. Bedrooms 3
☐ Mobile Home No. Bathrooms _____
☐ Business No. Employees _____
☐ Other _____


☐ Slab ☑ Crawl Space ☐ Basement w/plumbing ☐ Basement wo/plumbing

Water Supply: ☑ Individual ☐ Public ☐ Community

Comments:/Conditions: ① INSTALL LINES NO DEEPER THAN 20" ON CONTOUR ② CALL PRIOR TO INSTALLATION FOR PUMP SIZING & SYSTEM SPECS IF NECESSARY ③ MAINTAIN A MINIMUM 100' SETBACK FROM WELL

Comments:/Conditions: POLY LOK FILTER & MARKER
V'D PRESSURE & LWER 5-11-05
NEEDS ELECTRICAL LC COMPLETED 5-31-05 CS

INITIAL SITE SKETCH

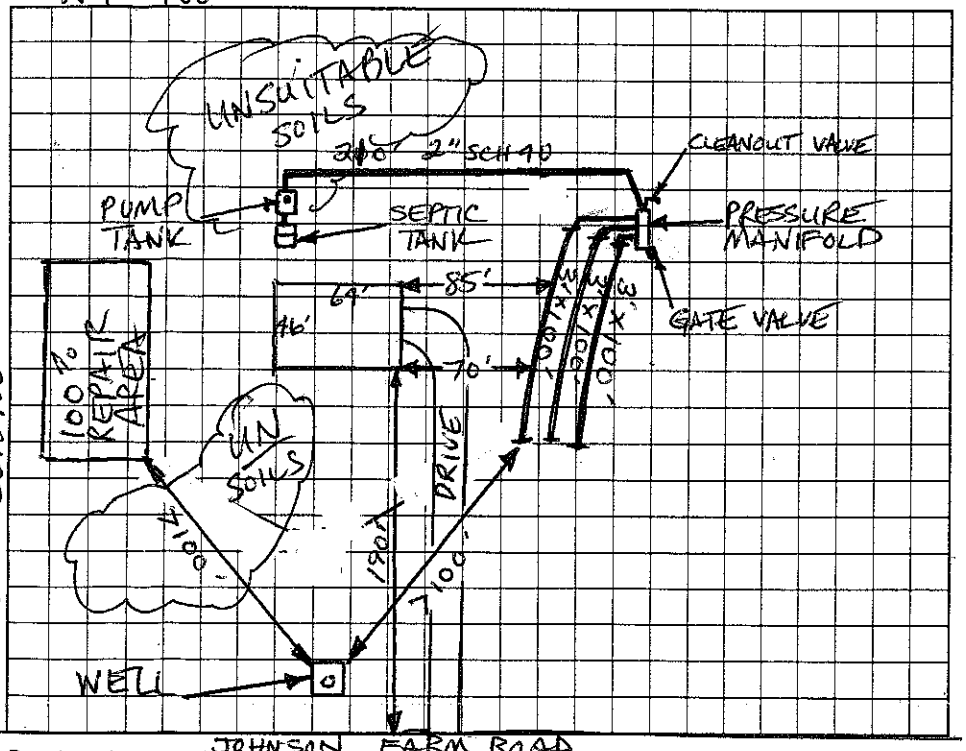

AS BUILT SKETCH

☐ PRESSURE CHECK / SYSTEM FINAL
☐ NEMA 4X
☐ PUMP & ALARM SEPARATE

Permit can be suspended or revoked if any false information is supplied toward securing the permit/any unauthorized changes are made to the site/any unauthorized changes are made in the installation of the system. Improvement Permit with plat valid without expiration. Improvement Permit with site plan valid for sixty months. Authorization to Construct is valid for a period equal to that of Improvement Permit – not to exceed sixty months.

Signed: Allison Bolick date _____ Installed by: ROWAN SEPTIC TANK

Improvement Permit by: Christopher M. Shell RS, LSS date 2-3-05 Operation Permit by: Christopher M. Shell, RS, LSS date 6-1-05

Authorization to Construct by: Christopher M. Shell RS, LSS date 2-3-05 Existing System Inspection by: _____ date _____

HEALTH DEPT. COPY: WHITE OWNER COPY (FINAL): YELLOW OWNER COPY (INITIAL): PINK

New owner - Howard Benno