IREDELL COUNTY HEALTH DEPARTMENT

STATESVILLE 704-878-5305 MOORESVILLE 704-664-5281

IMPROVEMENT PERMIT / CERTIFICATE OF COMPLETION / OPERATION PERMIT / EXISTING SYSTEM INSPECTION

PROPERTY DESCRIPTION NO. 070019 DATE 10-23-97 TAX MAP NO. 4709 48 5810 Watershed: Yes No

OWNER OR CONTRACTOR ROBERT & LEIGH BALL PHONE: Business Home 528-0848

ADDRESS 321 JOHNSON FARM ROAD

LOCATION NC 115 N TL PISGAH, TR JOHNSON FARM, 0.2 MILE ON RIGHT BACK OFF ROAD 800'

SUBDIVISION BLOCK / SECTION LOT LOT AREA 2 ACRES SITE CLASS. PS DESIGN FLOW 240 L.T.A.R. 0.33 GPD/FT²

Septic Tank: 1000 Gallons; STB Date 10-30-97

Pump Tank: Gallons; PT Date

Pump Make: Model Serial No.

Nitrification Field: No Fields 1 Square Feet 720 Linear Feet 240

No Lines THREE Trench Width 36" Max Trench Bottom Depth 36" Gravel Depth 12"

☑ New System ☐ Repair System Type: I, II, III, IV, V, VI

System Description: CONVENTIONAL GRAVITY

Repair System Description: CONV. GRAV/PUMP

Maintenance Agreement Required: ☐ Yes ☑ No

☐ House/Mod. Home ☑ Mobile Home ☐ Business ☐ Other

No. Bedrooms 3 No. Bathrooms 2 No. Employees

☐ Slab ☑ Crawl Space ☐ Basement w/plumbing ☐ Basement wo/plumbing

Water Supply: ☑ Individual ☐ Community ☐ Public


WELL NEXT DOOR

Comments:


Comments:

SCALE: 1"=60'

INITIAL SITE SKETCH

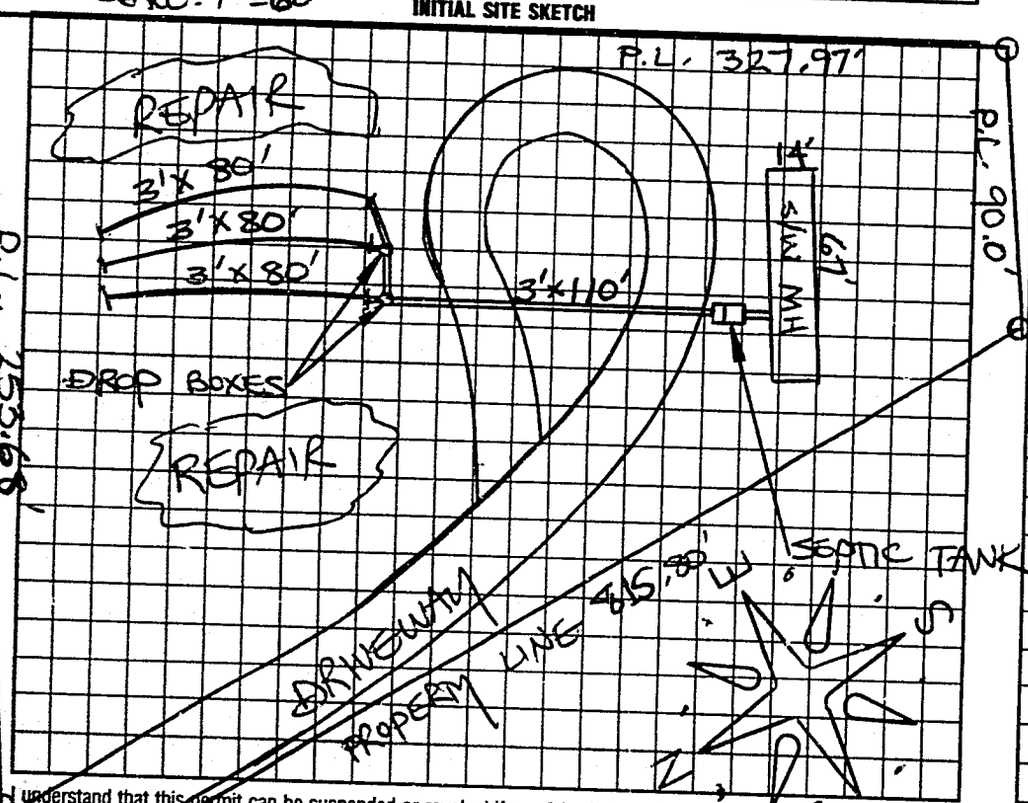

AS BUILT SKETCH

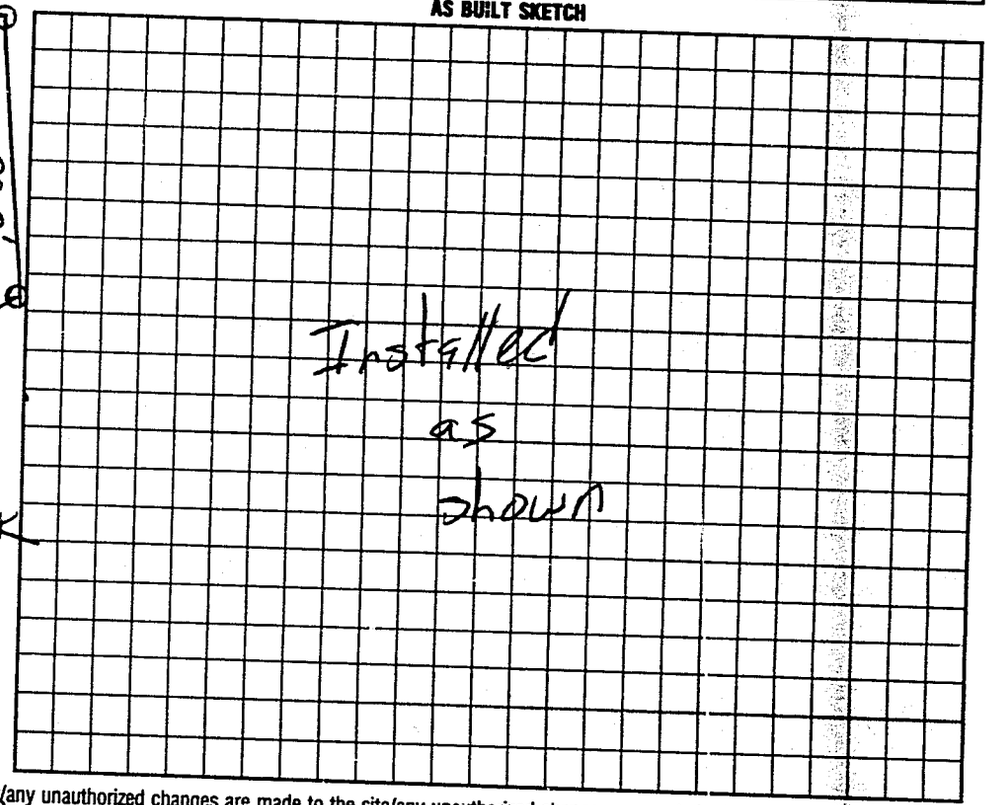

I understand that this permit can be suspended or revoked if any false information is supplied toward securing the permit/any unauthorized changes are made to the site/any unauthorized changes are made in the installation of the system. Improvement Permit is valid for 60 months from date of issuance. AUTHORIZATION TO CONSTRUCT IS VALID FOR 60 MONTHS FROM DATE OF ISSUANCE.

Signed: Robert C Ball

Improvement Permit by: STEVE HEDRICK date 10-23-97

AUTH. TO CONST.

Existing System Inspection by: STEVE HEDRICK date 10-23-97

Installed by: Andy Daniels

~~Certificate of Completion by:~~ date

Operation Permit by: Mark CONLEY date 1-14-98

HEALTH DEPT. COPY: WHITE INSPECTION COPY (FINAL): GREEN OWNER COPY (FINAL): YELLOW INSPECTION COPY (INITIAL): PINK OWNER COPY (INITIAL): GOLD