IREDELL COUNTY HEALTH DEPARTMENT - *ENVIRONMENTAL HEALTH* ☐ STATESVILLE OFFICE 704-878-5305 ☐ MOORESVILLE OFFICE 704-664-5281

IMPROVEMENT PERMIT / AUTHORIZATION TO CONSTRUCT / OPERATION PERMIT / EXISTING SYSTEM INSPECTION

PERMIT # 166159 PIN # 4709-59-6784 DATE 17 May 2011

OWNER Robert Pitts APPLICANT: PHONE: Home/Cell # 828-238-2230 Business #

SITE ADDRESS 152 Martins Farm Ln. Hiddenite OWNER / APPLICANT ADDRESS

SITE DIRECTIONS 115N TL Pisgah Ch. Rd. TR Johnson Farm Rd. TL Martin Farm Ln. TR Rose Gordon Ln.

SUBDIVISION BLOCK / SECTION LOT # LOT AREA 1.596 ac. DESIGN FLOW 360 g/d L.T.A.R. 0.3 g/ft²d


Septic Tank	1000	Gallons: STB	317	Date	12-23-08	☑ New System	☐ Repair	☐ Expansion System	Type I (II) III IV V VI
Pump Tank		Gallons: P T		Date		System Description:	Conventional		
Pump Make		Model		Serial #		Repair System Description:	Conventional		
No. Nitrification Fields:	1	No. Lines	4	Linear Feet	400	Maintenance Agreement Required	☐ YES	☑ NO	
Trench Width	36"	Max. Trench Bottom Depth	36"	Gravel Depth	12"	☑ GRAVITY	☐ PRESSURE		

☑ Residence	No. Bedrooms	3	Water Supply	
☐ Business	No. Persons		☑ Private	
☐ Other	No. Employees		☐ Public	
☐ Slab	☑ Crawl Space		☐ Community	
☐ Basement w/plumbing	☐ Basement w/o plumbing			

Comments / Conditions #4 An Accepted system may be used.

Arc 36

INITIAL SITE SKETCH

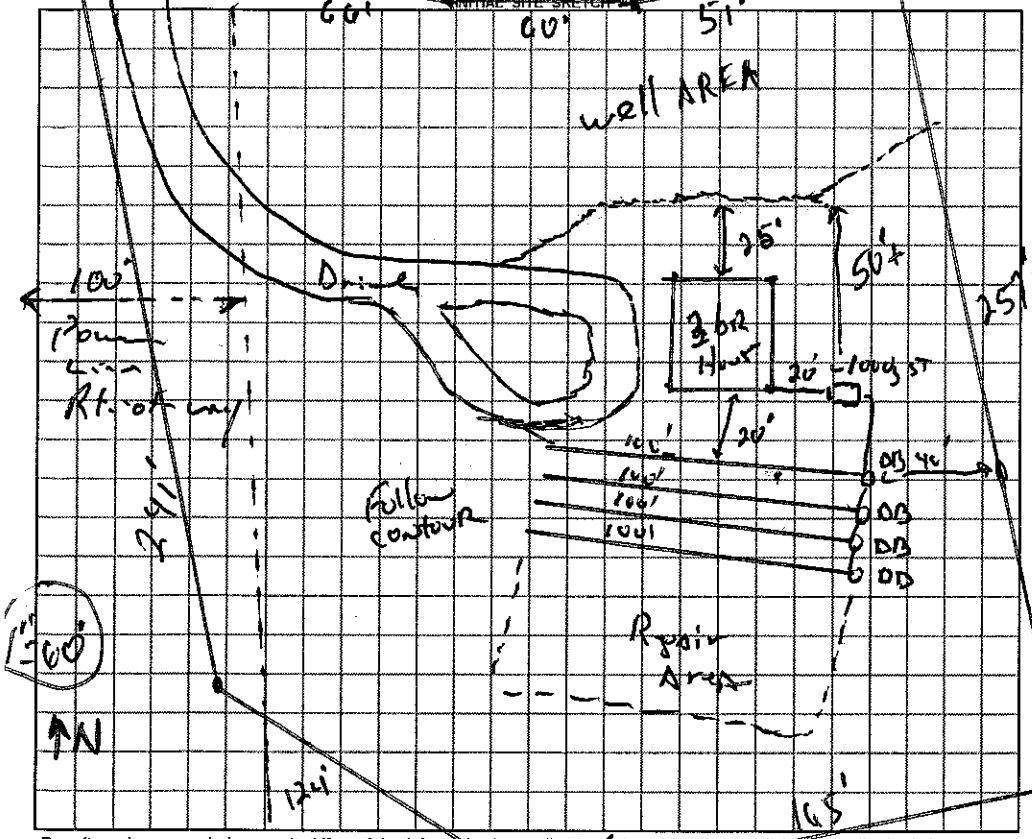

AS BUILT SKETCH

Permit can be suspended or revoked if any false information is supplied toward securing the permit, any unauthorized changes are made to the site / any unauthorized changes are made in the installation of the system.

☐ ***IMPROVEMENT PERMIT*** with plat valid without expiration ☑ ***IMPROVEMENT PERMIT*** with plat valid 60 mo. ~~expiration~~. site plan valid 60 mo. ☑ ***AUTHORIZATION TO CONSTRUCT*** valid for period equal to IMPROVEMENT PERMIT--not to exceed 60 mo.

Owner / Applicant Signature: Date 5-20-11 Installed by: Kelly Welborn

IMPROVEMENT PERMIT by: REHS Date 17 May 11 OPERATION PERMIT by: REHS Date 4-30-12

AUTHORIZATION TO CONSTRUCT by: REHS Date 17 May 11 Existing System Inspected by: REHS Date

YOU SHOULD CONTACT A LOCATOR SERVICE PRIOR TO ANY EXCAVATION

White Copy – Environmental Health YELLOW COPY (Final) Owner / Applicant PINK COPY (Initial) Owner / Applicant